(9:30)

IREDELL COUNTY HEALTH DEPARTMENT

STATESVILLE 704-878-5305 MOORESVILLE 704-664-5281

IMPROVEMENT PERMIT / CERTIFICATE OF COMPLETION / OPERATION PERMIT / EXISTING SYSTEM INSPECTION

PROPERTY DESCRIPTION NO. 22701 DATE April 29, '96 TAX MAP NO. part of 2LA11 / 4626-49-5633 Watershed: ☑ Yes ☐ No

OWNER OR CONTRACTOR Easter Development Corp. PHONE: Business 664-2906 Home

ADDRESS 227 Hibernia Lane, Mooresville

LOCATION Brawley Sch Rd. TR McKendree TR High Circle on right corner lot w/ Mountain Ash

SUBDIVISION Hawks West BLOCK / SECTION LOT 5 LOT AREA .56 ac SITE CLASS PS per 1936 DESIGN FLOW 360 gpd L.T.A.R. .3

Septic Tank: 1000 Gallons; STB 794 Date 2/27/97

Pump Tank: Gallons; PT Date

Pump Make: Model Serial No.

Nitrification Field: No Fields 1 Square Feet 900 Linear Feet 300

No Lines 3 Trench Width 36" Max Trench Bottom Depth 36" Gravel Depth N/A

☑ New System ☐ Repair System Type: I, II, (III), IV, V, VI

System Description: gravity chambered

Repair System Description: gravity chambered

Maintenance Agreement Required: ☐ Yes ☑ No

☑ House/Mod. Home No. Bedrooms 3

☐ Mobile Home No. Bathrooms 2½

☐ Business No. Employees

☐ Other

☐ Slab ☑ Crawl Space ☐ Basement w/plumbing ☐ Basement wo/plumbing


Water Supply: ☑ Individual ☐ Community ☐ Public

Comments:


Comments:

1" = 50'

INITIAL SITE SKETCH

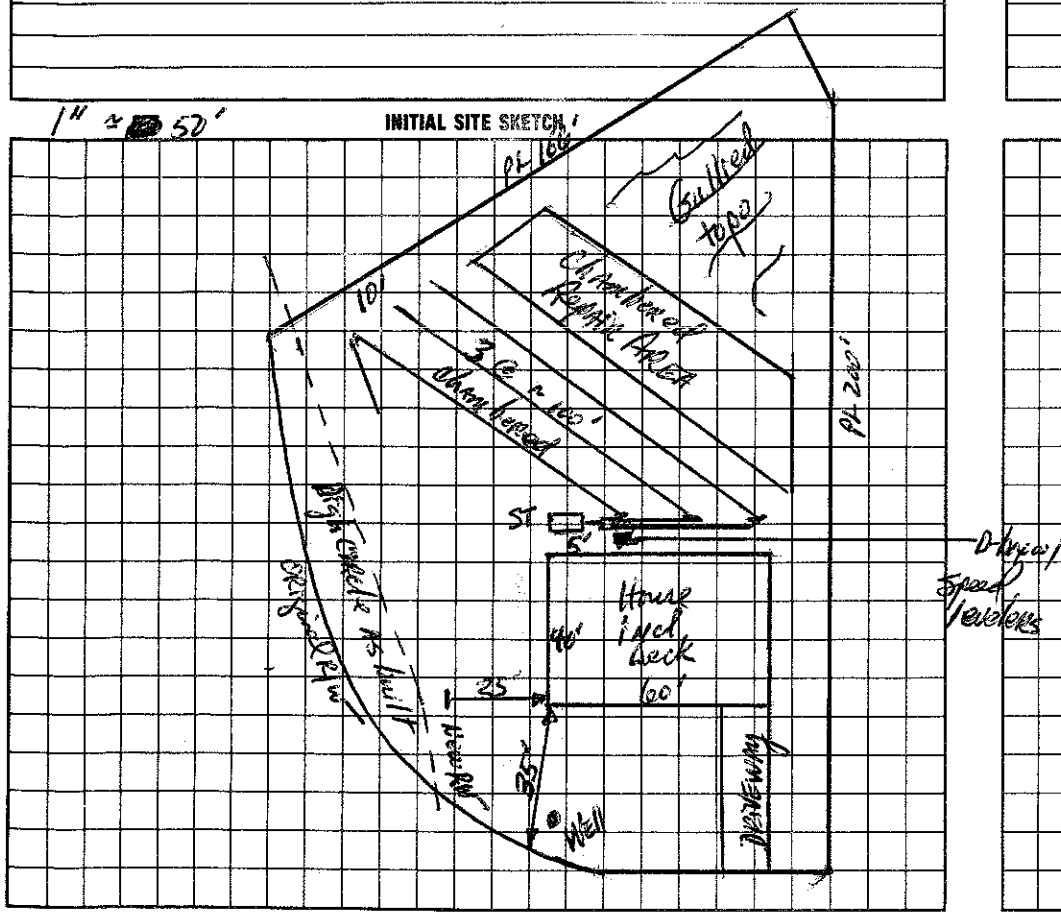

AS BUILT SKETCH

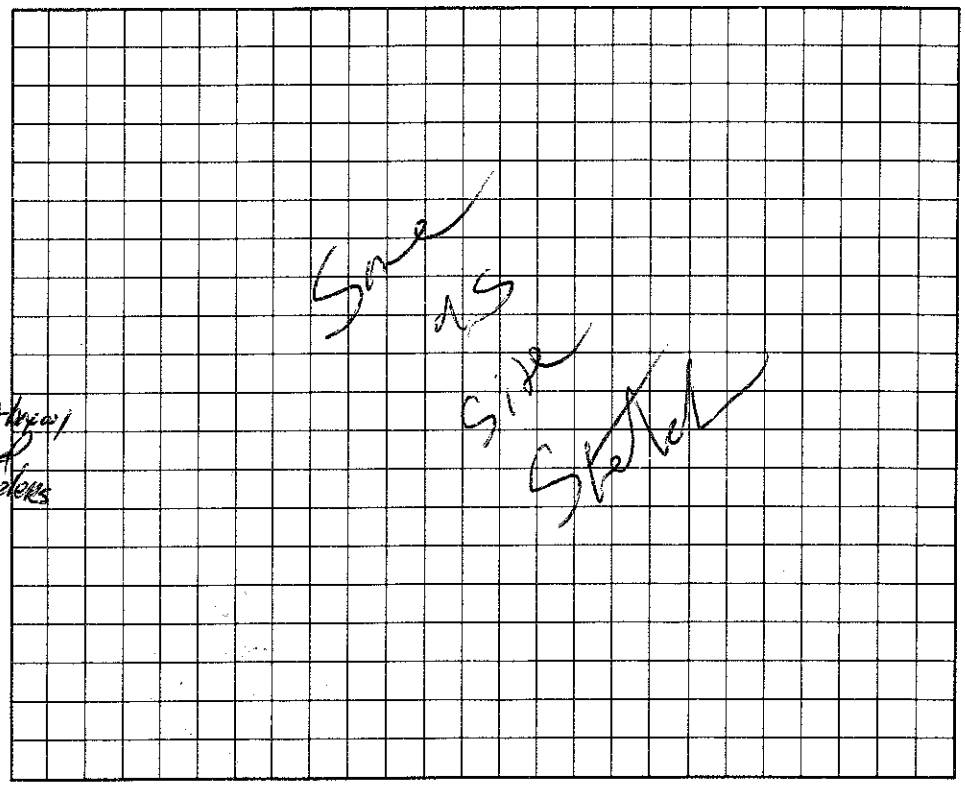

I understand that this permit can be suspended or revoked if any false information is supplied toward securing the permit/any unauthorized changes are made to the site/any unauthorized changes are made in the installation of the system.

Signed:

Improvement Permit by: date 4-29-96

Existing System Inspection by: date 12-3-96

Installed by: CURT DUNNING

Certificate of Completion by: date

Operation Permit by: date 5/29/97

HEALTH DEPT. COPY: WHITE INSPECTION COPY (FINAL): GREEN OWNER COPY (FINAL): YELLOW INSPECTION COPY (INITIAL): PINK OWNER COPY (INITIAL): GOLD