IREDELL COUNTY HEALTH DEPARTMENT

STATESVILLE 704-878-5305 MOORESVILLE 704-664-5281

IMPROVEMENT PERMIT / CERTIFICATE OF COMPLETION / OPERATION PERMIT / EXISTING SYSTEM INSPECTION

PROPERTY DESCRIPTION NO. 22499 DATE 11/13/97 TAX MAP NO. pt 1 7LA11 Watershed: ☑ Yes ☐ No

OWNER OR CONTRACTOR EASTER DEVELOPMENT CORP PHONE: Business ~~Home~~ 4626-49-5921

ADDRESS 227 HIDEAWAY LN MOORESVILLE

LOCATION BRAWLEY SCHOOL RD - TR MCKENDREE - TR OFF CIRCLE ON RT

SUBDIVISION HAWKS NEST BLOCK / SECTION ____ LOT 3 LOT AREA .7AC SITE CLASS. IS DESIGN FLOW 360 gpd L.T.A.R. .3 GPD/FT²

Septic Tank: 1000 Gallons; STB 1012 Date 10-8-97

Pump Tank: ____ Gallons; PT ____ Date ____

Pump Make: ____ Model ____ Serial No. ____

Nitrification Field: No Fields 1 Square Feet 900 Linear Feet 300

No Lines 6 @ 50' Trench Width 36" Max Trench Bottom Depth 36" Gravel Depth N/A

☑ New System ☐ Repair System Type: I, II, (III), IV, V, VI

System Description: GRAVITY CHAMBERED OR HDS

Repair System Description: PUMP PANEL

Maintenance Agreement Required: ☐ Yes ☑ No

☑ House/Mod. Home No. Bedrooms 3

☐ Mobile Home No. Bathrooms 2.5

☐ Business No. Employees ____

☐ Other ____


☐ Slab ☑ Crawl Space ☐ Basement w/plumbing ☐ Basement wo/plumbing

Water Supply: ☑ Individual ☐ Community ☐ Public

Comments: * REVISED

Comments: LINES LEFT OPEN IN RAIN - HIGH RATE OF SATURATION.

INITIAL SITE SKETCH 1" = 50'

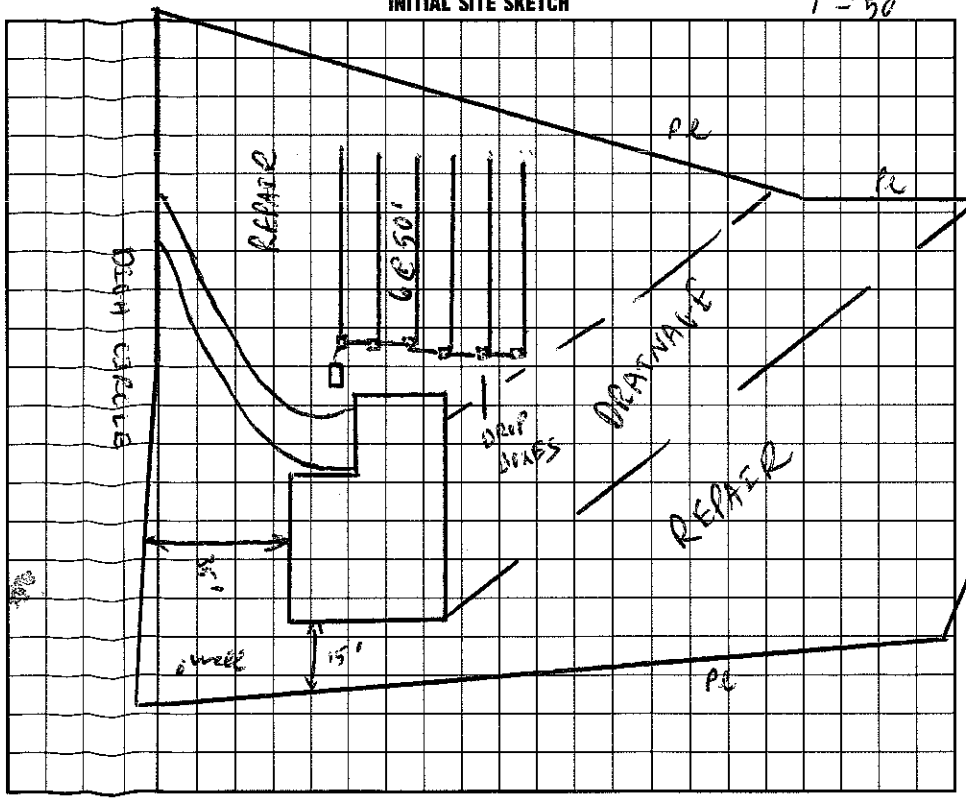

AS BUILT SKETCH

I understand that this permit can be suspended or revoked if any false information is supplied toward securing the permit/any unauthorized changes are made to the site/any unauthorized changes are made in the installation of the system. Improvement Permit is valid for 60 months from date of issuance.

Signed: ____

Improvement Permit by: ____ date 11/13/97

Existing System Inspection by: ____ date 11/13/97

Installed by: ATLANTIC GRADING

Certificate of Completion by: ____ date ____

Operation Permit by: ____ date 1/28/98

HEALTH DEPT. COPY: WHITE INSPECTION COPY (FINAL): GREEN OWNER COPY (FINAL): YELLOW INSPECTION COPY (INITIAL): PINK OWNER COPY (INITIAL): GOLD