IREDELL COUNTY HEALTH DEPARTMENT

(3:30-4:00)

STATESVILLE 704-878-5305 MOORESVILLE 704-664-5281

IMPROVEMENT PERMIT / CERTIFICATE OF COMPLETION / OPERATION PERMIT / EXISTING SYSTEM INSPECTION

PROPERTY DESCRIPTION NO. 22702 DATE April 29, '96 TAX MAP NO. part of 2LA11 / 4626-49-6631 Watershed: ☒ Yes ☐ No

OWNER OR CONTRACTOR Easter Development Corp. PHONE: Business 664-2906 Home

ADDRESS 227 Hideaway LANE Mooresville

LOCATION Brawley Sch Rd. TR Mickentree TR Dish Coale TR Montclair (1st street) TL Scottsdale 1st on left (corner)

SUBDIVISION Hawks Nest BLOCK / SECTION LOT 6 LOT AREA .5Ac SITE CLASS. Spec. Fill DESIGN FLOW 360gpd L.T.A.R. ~.3

Septic Tank: 1000 Gallons; STB 1012 Date 10/8/97

Pump Tank: 1000 Gallons; PT Date

Pump Make: GOULDS Model WE03 11HP Serial No. M9728815

Nitrification Field: No Fields 1 Square Feet 1200 Linear Feet 400

No Lines 4@ 100' Trench Width 36" Max Trench Bottom Depth 36" Gravel Depth 12"

☒ New System ☐ Repair System Type: I. II. III IV. V. VI

System Description: pumped-pw- conventional

Repair System Description: LP panel blocks

Maintenance Agreement Required: ☐ Yes ☒ No

☒ House/Mod. Home No. Bedrooms 3

☐ Mobile Home No. Bathrooms 2½

☐ Business No. Employees

☐ Other

☐ Slab ☒ Crawl Space ☐ Basement w/plumbing ☐ Basement wo/plumbing


Water Supply: ☒ Individual ☐ Community ☐ Public

Comments: (TANK LOCATIONS CHANGED to left of House)

Comments:

1" = 50'

INITIAL SITE SKETCH

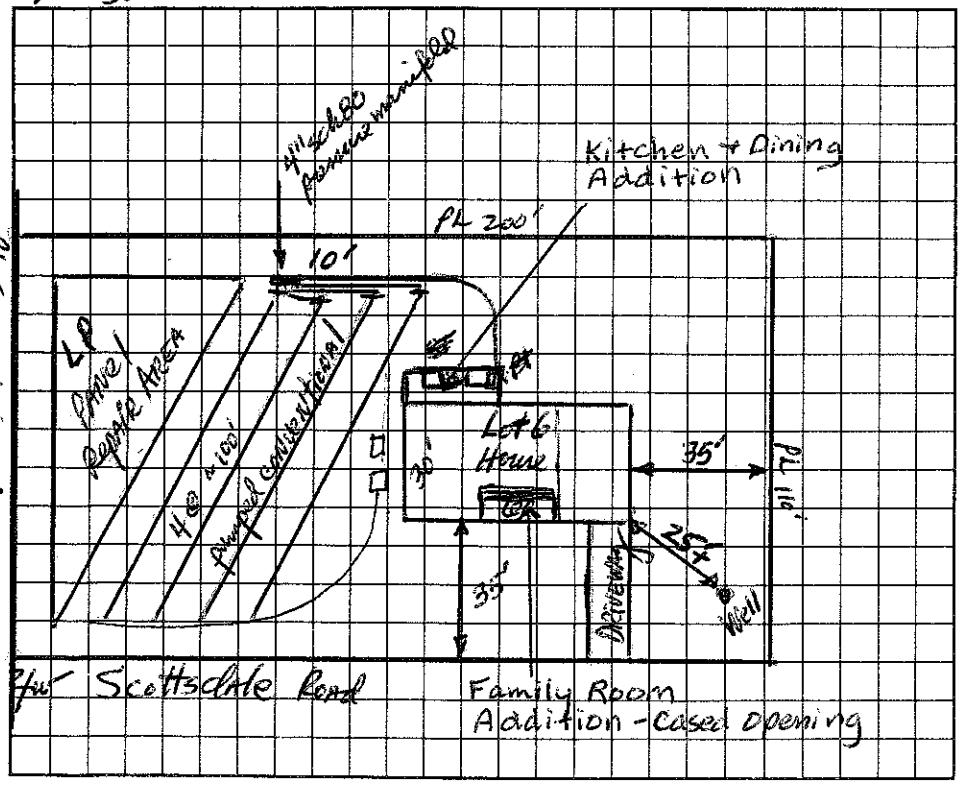

AS BUILT SKETCH

I understand that this permit can be suspended or revoked if any false information is supplied toward securing the permit/any unauthorized changes are made to the site/any unauthorized changes are made in the installation of the system.

Signed:

Improvement Permit by: date 4-29-96

Existing System Inspection by: date 12-3-96

Installed by: TOMMY COTHREN

Certificate of Completion by: date

Operation Permit by: date 1/28/98

HEALTH DEPT. COPY: WHITE INSPECTION COPY (FINAL): GREEN OWNER COPY (FINAL): YELLOW INSPECTION COPY (INITIAL): PINK OWNER COPY (INITIAL): GOLD