Site Address: 118 Montclair Dr.

IREDELL COUNTY HEALTH DEPARTMENT

STATESVILLE 704-878-5305

MOORESVILLE

IMPROVEMENT PERMIT / AUTHORIZATION TO CONSTRUCT / OPERATION PERMIT / EXISTING SYSTEM INSPECTION

DATE 4-20-07

PERMIT# 139652 213626 PIN# 4626581913.559 4626-49-8381 PHONE: Business Home

OWNER OR APPLICANT The Farms LLC Robert Volles

ADDRESS 2214 Brawley School Rd Mooresville NC 28117

LOCATION Brawley School Rd TR McKendree TR Digh Circle TR Montclair TR Silver Lake Trail on left

SUBDIVISION The Farms BLOCK / SECTION 5 LOT 559 LOT AREA 1.55 Ac SITE CLASS. PS DESIGN FLOW 480 L.T.A.R. .625

Septic Tank: 1500 * Gallons: STB 336 Date 3-22-16

Pump Tank: 1500 * Gallons: PT 477 Date 3-4-14

Pump Make: GOULDS Model WE05HHU Serial No.

Nitrification Field: No Fields 1 Square Feet 960 Linear Feet 320'

No Lines 4@80' Trench Width 24"min Max Trench Bottom Depth 36"

☑ New System ☐ Repair ☐ Expansion System Type: I II III IV V VI

System Description: LP PPBPS

Repair System Description: LP PPBPS

Maintenance Agreement Required: ☑ Yes ☐ No

Gravel Depth NA ☐ Gravity ☑ Pressure ☐ Slab ☐ Crawl Space ☑ Basement w/plumbing ☐ Basement wo/plumbing

☑ House/Mod. Home ☐ Mobile Home ☐ Business ☐ Other

No. Bedrooms 4 No. Persons 8 No. Employees

Water Supply: ☐ Individual ☑ Public ☑ Community

Comments/Conditions: * Per plan Specs

Before AC verify elevations

Comments/Conditions: 10/6/15 Renewed Floor plans, in compliance with Septic plan, Note: House slightly larger but shouldn't impact Septic

INITIAL SITE SKETCH

See Plan from SW ME

AS BUILT SKETCH

Checked Tanks 4-28-14 RA

Checked Lines 5-9-16 RA

5-10-16: Pre Set head. Pressure Transducer Used Alarm @ 20 Override @ 19 -SD

Short Level 5'

Permit can be suspended or revoked if any false information is supplied toward securing the permit/any unauthorized changes are made to the site/any unauthorized changes are made in the installation of the system. Improvement Authorization to Construct is valid for a period equal to that of Improvement Permit – not to exceed sixty months.


Permit with plat valid without expiration ☐ Improvement Permit with site plan valid for sixty months ☑

Signed: _____ date 4-30-07 Installed by: STANLEY date 5-27-2016

Improvement Permit by: Judy McAuliffe RS date 4-20-07 Operation Permit by: _____ date _____

Authorization to Construct by: _____ date 10/6/15 Existing System Inspection by: _____

HEALTH DEPT. COPY: WHITE OWNER COPY (FINAL): YELLOW OWNER COPY (INITIAL): PINK

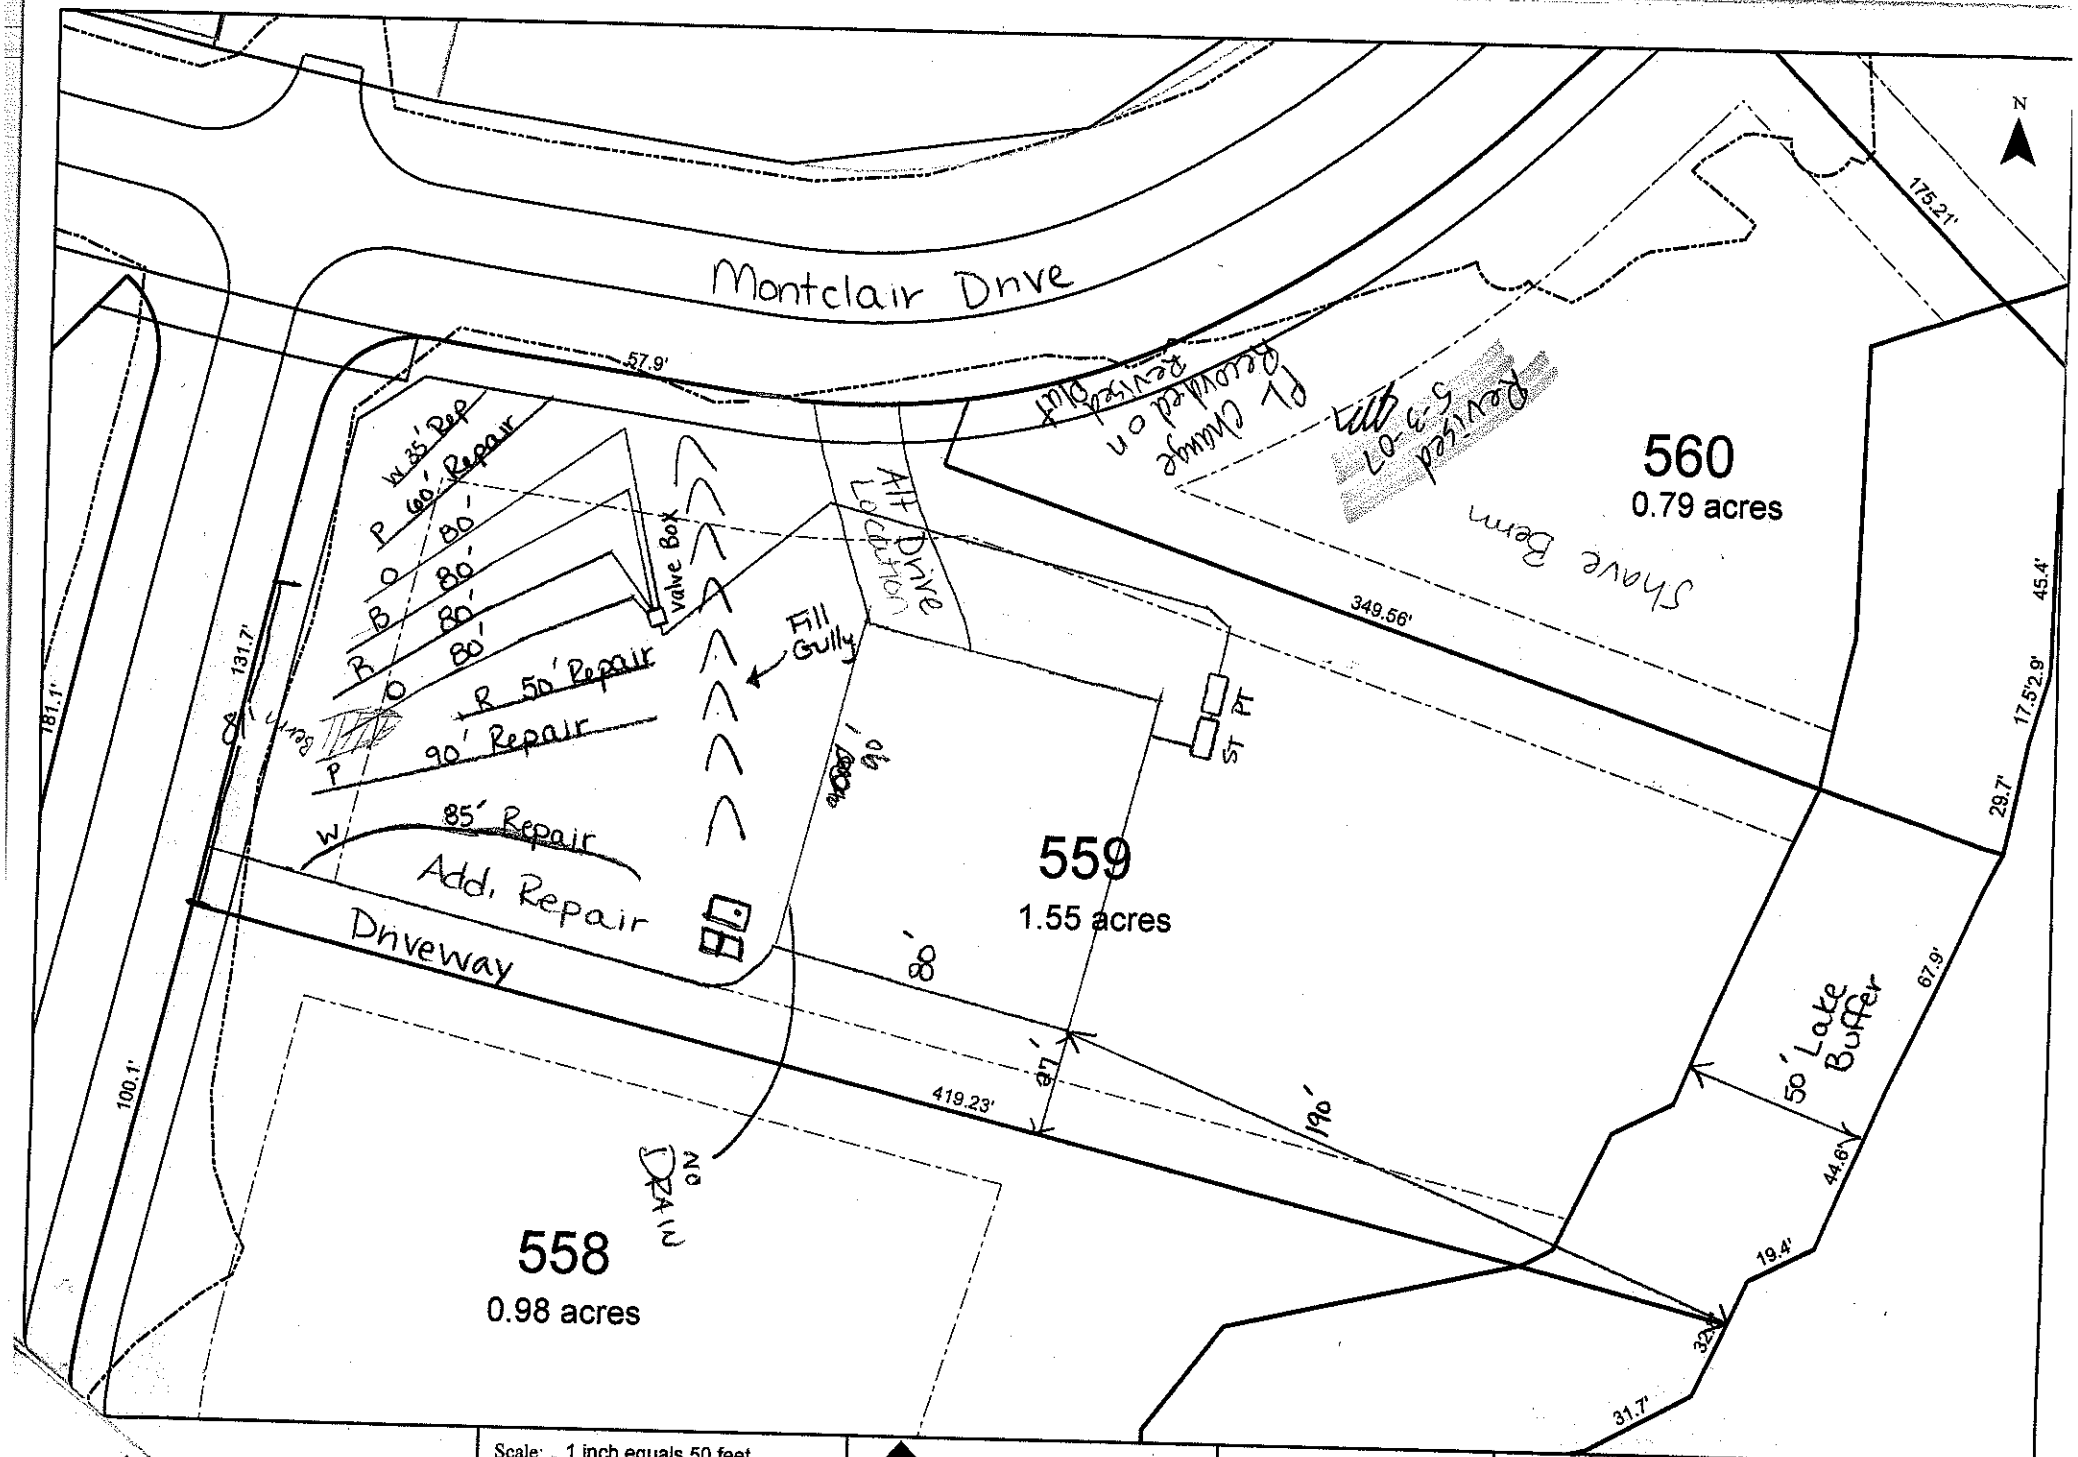

Scale: 1 inch equals 50 feet	S&ME ENVIRONMENTAL SERVICES • ENGINEERING • TESTING	The Farms - Phase V	FIGURE
Drawn by: JBP		Lot 559	1
Reviewed by: KS		Iredell County, NC	
Date: February, 2007		S&ME Project #1588-05-070	