IREDELL COUNTY HEALTH DEPARTMENT

STATESVILLE 704-878-5305 MOORESVILLE 704-664-5281

IMPROVEMENT PERMIT / CERTIFICATE OF COMPLETION / OPERATION PERMIT / EXISTING SYSTEM INSPECTION

PROPERTY DESCRIPTION NO. 2068 DATE March 28, 95 TAX MAP NO. part of 2CA3 / 4626-50-0292 Watershed: ☐ Yes ☐ No

OWNER OR CONTRACTOR Laussy Burbank PHONE: Business Home

ADDRESS PO Box 176 Davidson

LOCATION Brawley School Rd TR, Bay Harbour Rd. 3rd lot on left past Peregrin Ct.

SUBDIVISION The Harbour BLOCK / SECTION 1 LOT 65 LOT AREA 30,788 SITE CLASS. Ppn 96 DESIGN FLOW 480gpd L.T.A.R. .3

Septic Tank: 1000 Gallons; STB 794 Date 10/20/95

Pump Tank: Gallons; PT Date

Pump Make: Model Serial No.

Nitrification Field: No Fields 1 Square Feet 1200 Linear Feet 400

No Lines 5 Trench Width 36" Max Trench Bottom Depth 36" Gravel Depth N/A

☑ New System ☐ Repair System Type: I, II, III, IV, V, VI

System Description: gravity INNOVATOR

Repair System Description: SAME

Maintenance Agreement Required: ☐ Yes ☑ No

☑ House/Mod. Home No. Bedrooms 4

☐ Mobile Home No. Bathrooms 2.5

☐ Business No. Employees

☐ Other

☐ Slab ☑ Crawl Space ☐ Basement w/plumbing ☐ Basement wo/plumbing


Water Supply: ☐ Individual ☑ Community ☐ Public

Comments:


Comments:

1"=40'

INITIAL SITE SKETCH

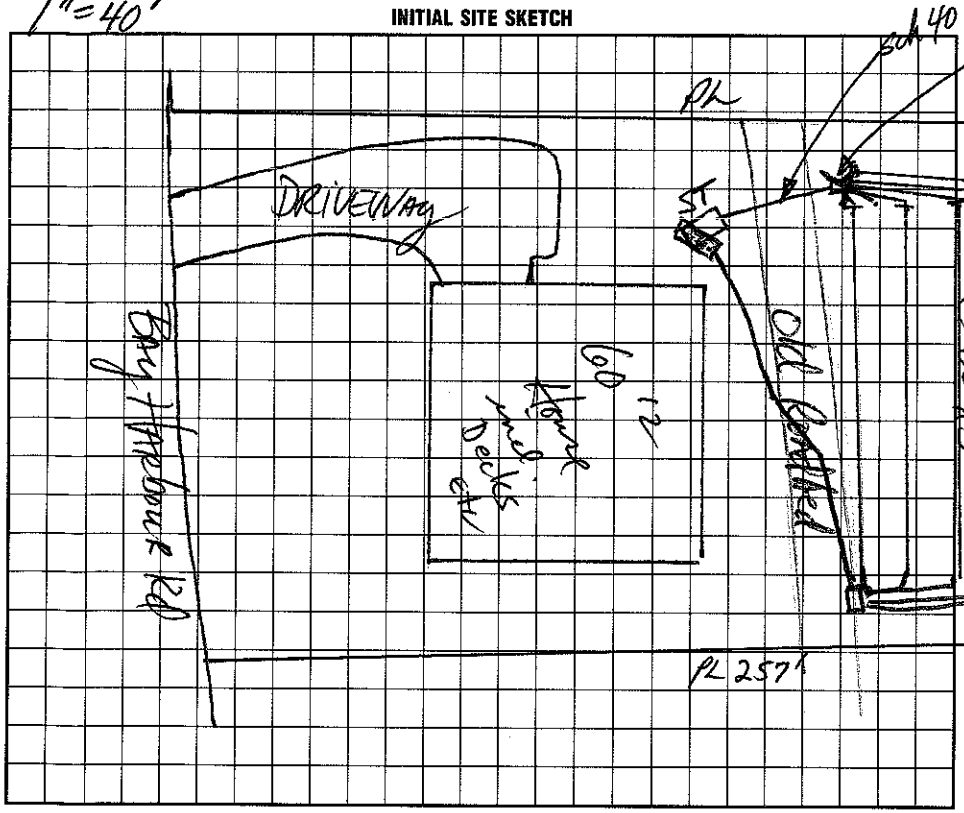

AS BUILT SKETCH

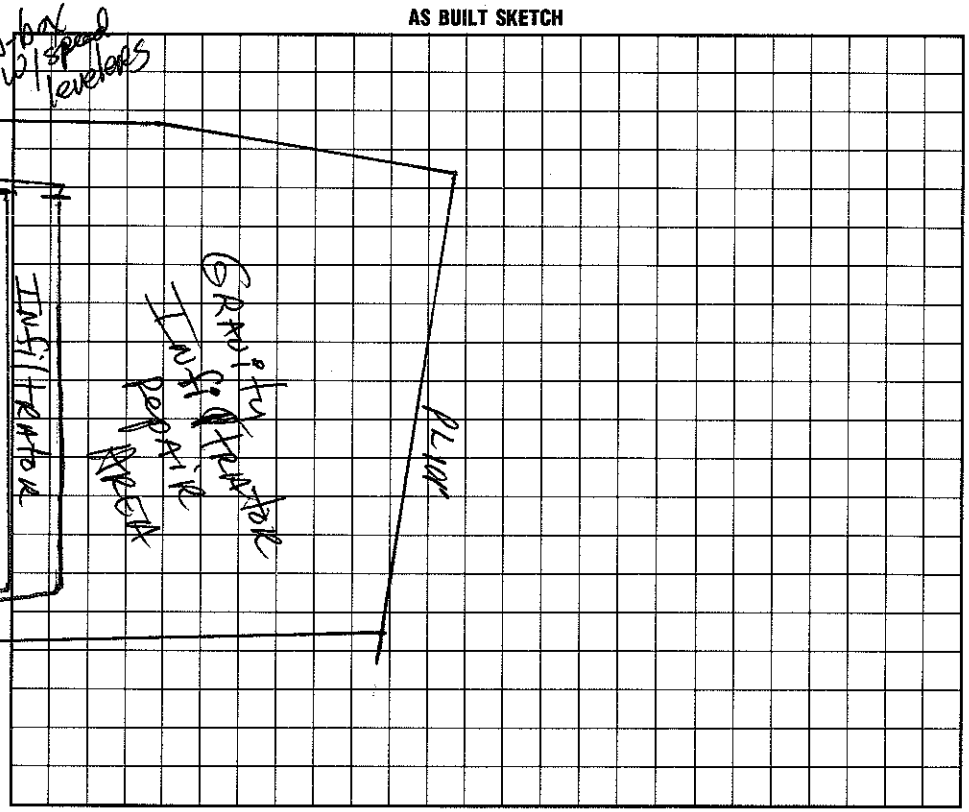

I understand that this permit can be suspended or revoked if any false information is supplied toward securing the permit/any unauthorized changes are made to the site/any unauthorized changes are made in the installation of the system. Improvement Permit is valid for 60 months from date of issuance.

Signed:

Improvement Permit by: Jana Hinson, RS date 3/28/95

Existing System Inspection by: date

Installed by: Barry Thompson

Certificate of Completion by: Wesley Sparks RS. date 2/9/96

Operation Permit by: Wesley Sparks RS. date 2/9/96

HEALTH DEPT. COPY: WHITE INSPECTION COPY (FINAL): GREEN OWNER COPY (FINAL): YELLOW INSPECTION COPY (INITIAL): PINK OWNER COPY (INITIAL): GOLD