IREDELL COUNTY HEALTH DEPARTMENT

Authorization to Construct

STATESVILLE 704-878-5305 MOORESVILLE 704-664-5281

IMPROVEMENT PERMIT / ~~CERTIFICATE OF COMPLETION~~ / OPERATION PERMIT / EXISTING SYSTEM INSPECTION

PROPERTY DESCRIPTION NO. 23095 DATE 3/13/96 TAX MAP NO. 2F 12 A 76 Watershed: X Yes ☐ No

OWNER OR CONTRACTOR Jerry Burbank PHONE: Business 896-0568 Home 4626-50-0547

ADDRESS PO Box 176 Davidson, NC. 28036

LOCATION Brawley Sch Rd TR Bay Harbour lot on (R) 3rd lot past Pine Cliff Ln.

SUBDIVISION The Harbour BLOCK / SECTION 1 MAPC LOT 76 LOT AREA .88 Ac SITE CLASS PS DESIGN FLOW 480 L.T.A.R. .3

Septic Tank: 1000 Gallons; STB 825 Date 5/27/96

Pump Tank: ____ Gallons; PT ____ Date ____

Pump Make: ____ Model ____ Serial No. ____

Nitrification Field: No Fields 1 Square Feet 1600 Linear Feet ~~400~~

No Lines 5 Trench Width 36" Max Trench Bottom Depth 32" Gravel Depth 6" SAND

X New System ☐ Repair System Type: I II III IV V VI

System Description: Divider - Chamber Plastic

Repair System Description: Same

Maintenance Agreement Required: ☐ Yes X No

X House/Mod. Home No. Bedrooms 4

☐ Mobile Home No. Bathrooms 2.5

☐ Business No. Employees ____

☐ Other ____


☐ Slab X Crawl Space ☐ Basement w/plumbing ☐ Basement wo/plumbing

Water Supply:
☐ Individual
X Community
☐ Public


Comments: * Chamber Plastic drain lines
* Sand backfill to top of louvers required

Comments:

INITIAL SITE SKETCH

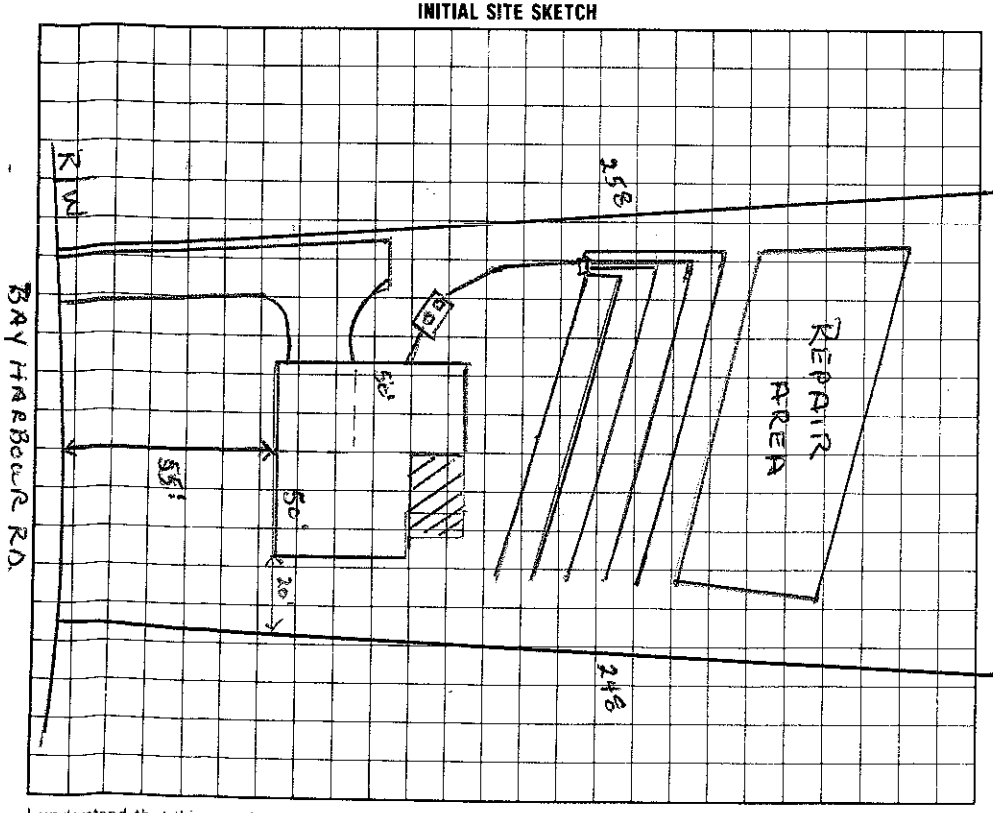

AS BUILT SKETCH

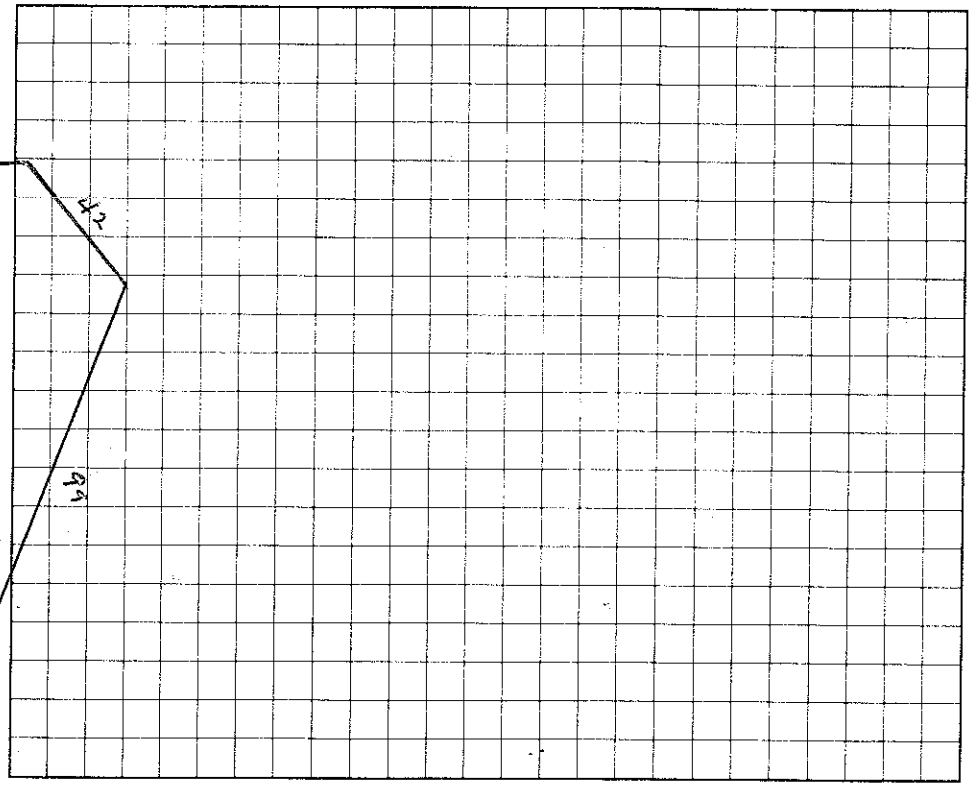

I understand that this permit can be suspended or revoked if any false information is supplied toward securing the permit/any unauthorized changes are made to the site/any unauthorized changes are made in the installation of the system

Signed: Authorization to Construct valid 5 years.

Improvement Permit by: Wesley Sparks RS. date 3/13/96

Existing System Inspection by: Auth. to Construct. Wesley Sparks RS. date 3/13/96

Installed by: Bary Thompson

Certificate of Completion by: ____ date ____

Operation Permit by: Wesley Sparks RS. date 7/1/96

HEALTH DEPT. COPY: WHITE INSPECTION COPY (FINAL): GREEN OWNER COPY (FINAL): YELLOW INSPECTION COPY (INITIAL): PINK OWNER COPY (INITIAL): GOLD