IREDELL COUNTY HEALTH DEPARTMENT

Authorization to Construct

STATESVILLE 704-878-5305 MOORESVILLE 704-664-5281

IMPROVEMENT PERMIT / ~~CERTIFICATE OF COMPLETION~~ / OPERATION PERMIT / EXISTING SYSTEM INSPECTION

PROPERTY DESCRIPTION NO. 23163 DATE 3/5/96 TAX MAP NO. 2F 12A 77 Watershed: X Yes ☐ No

OWNER OR CONTRACTOR Jerry Burbank PHONE: Business 896-0568 ~~Home~~ 4626-50-1640

ADDRESS PO Box 176 / Davidson, NC. 28036

LOCATION Brawley School / TR Bay Harbour on (R) side between the two cul de sac on (R) side

SUBDIVISION Harbour BLOCK / SECTION 1 ~~PHASE~~ LOT 77 LOT AREA .57 SITE CLASS. PS DESIGN FLOW 480 L.T.A.R. .35

Septic Tank: 1000 Gallons; STB 794 Date

Pump Tank: Gallons; PT Date

Pump Make: Model Serial No.

Nitrification Field: No Fields 1 Square Feet 1371 Linear Feet 340 *

No Lines 4 Trench Width 36" Max Trench Bottom Depth 32" Gravel Depth 6" SAND

X New System ☐ Repair System Type: I. II. III. IV. V. VI

System Description: Gravity Chambered Plastic Same

Repair System Description:

Maintenance Agreement Required: ☐ Yes X No

X House/Mod. Home No. Bedrooms 4

☐ Mobile Home No. Bathrooms 3

☐ Business No. Employees

☐ Other


☐ Slab X Crawl Space ☐ Basement w/plumbing ☐ Basement wo/plumbing

Water Supply: ☐ Individual X Community ☐ Public


Comments: Diversion ditch required on Right side of lot as shown

Comments:

INITIAL SITE SKETCH

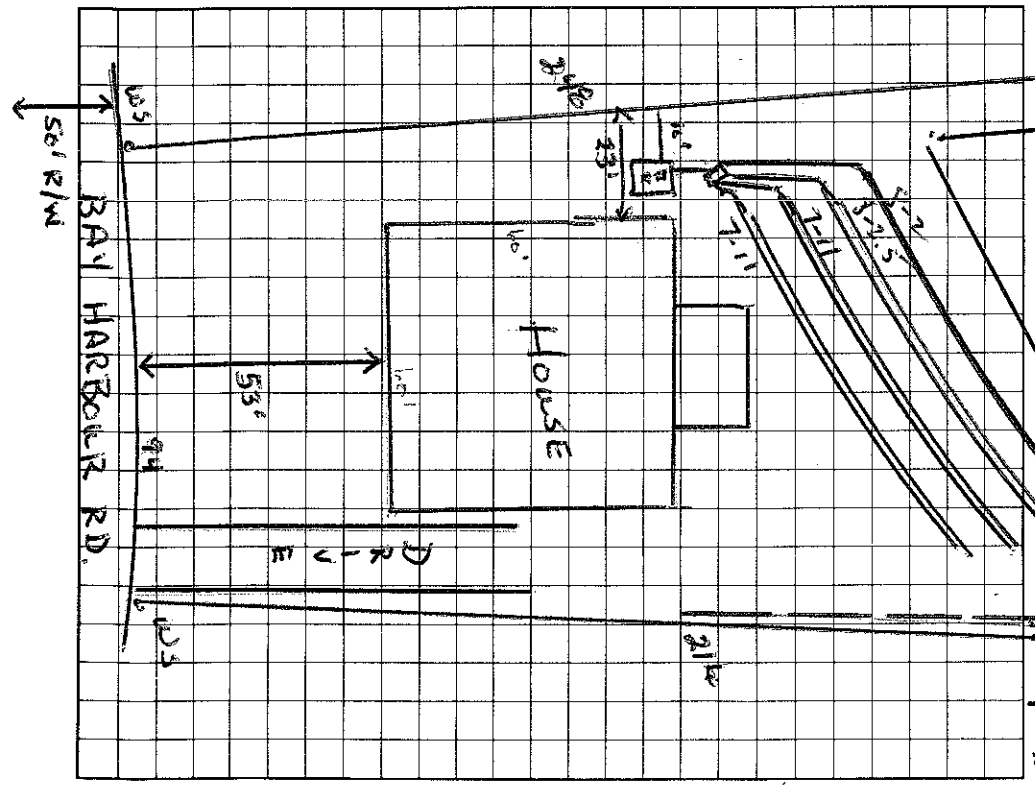

AS BUILT SKETCH

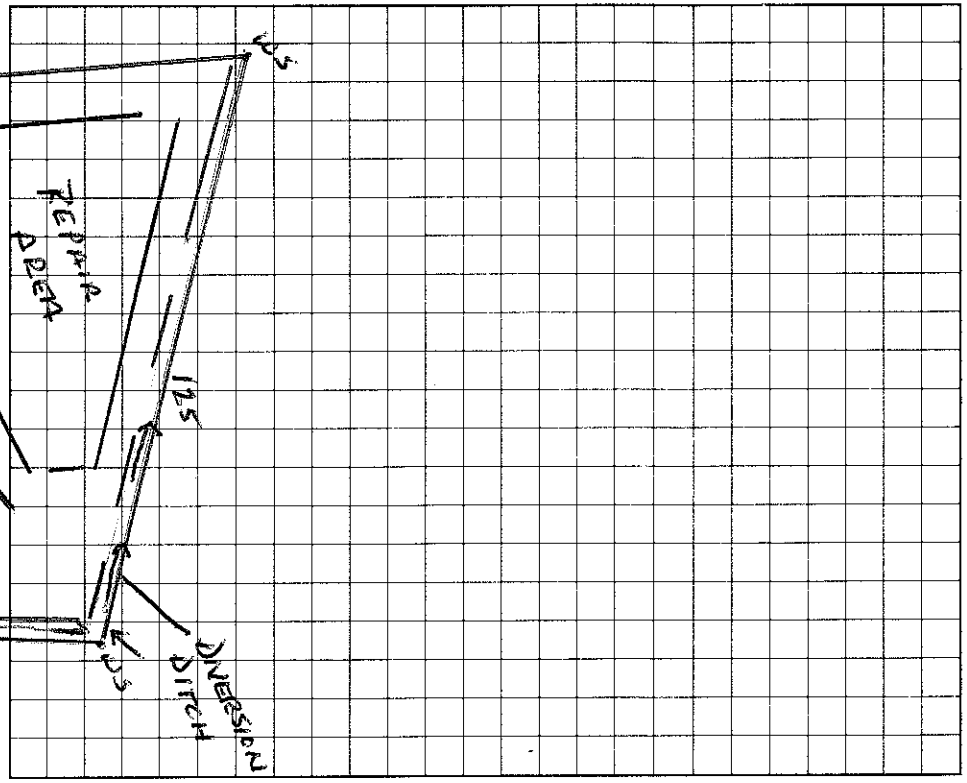

I understand that this permit can be suspended or revoked if any false information is supplied toward securing the permit/any unauthorized changes are made to the site/any unauthorized changes are made in the installation of the system.

Authorization to Construct valid for 5 years.

Signed:

Improvement Permit by: Wesley Sparks RS. date 3/5/96

Authorization to Construct Existing System Inspection by: Wesley Sparks RS. date 3/5/96

Installed by: Mac Lord

Certificate of Completion by: date

Operation Permit by: Wesley Sparks RS. date 7/15/96

HEALTH DEPT. COPY: WHITE INSPECTION COPY (FINAL): GREEN OWNER COPY (FINAL): YELLOW INSPECTION COPY (INITIAL): PINK OWNER COPY (INITIAL): GOLD