IREDELL COUNTY HEALTH DEPARTMENT

STATESVILLE 704-878-5305 MOORESVILLE 704-664-5281

IMPROVEMENT PERMIT / CERTIFICATE OF COMPLETION / OPERATION PERMIT / EXISTING SYSTEM INSPECTI

PROPERTY DESCRIPTION NO. 20150 DATE 3-22-95 TAX MAP NO. Part of 2CA3

OWNER OR CONTRACTOR Saussy Burbank PHONE: Business 4626-56-2397 Home Watershed: ☑ Yes ☐ No

ADDRESS Po Box 176 Davidson, N.C. WSIV

LOCATION Brawly School Rd TR Bay Harbor Dr. on left Corner of Peregrin Ct.

SUBDIVISION The Harbor BLOCK / SECTION 1 LOT 63 LOT AREA 20,000 SF SITE CLASS. PS DESIGN FLOW 480 gpl L.T.A.R. .3

Septic Tank: 1000 Gallons; STB 794 Bellinger Date 4-18-95

Pump Tank: _____ Gallons; PT _____ Date _____

Pump Make: _____ Model _____ Serial No. _____

Nitrification Field: No Fields 1 Square Feet 1600 Linear Feet 534

No Lines 5 Trench Width 36" Max Trench Bottom Depth 30" Gravel Depth 12"

☐ New System ☐ Repair System Type: I, II, III, IV, V, VI

System Description: Gravity Conv.

Repair System Description: Pump To PPBPS

Maintenance Agreement Required: ☐ Yes ☑ No

☑ House/Mod. Home No. Bedrooms 4

☐ Mobile Home No. Bathrooms 2½

☐ Business No. Employees ____

☐ Other _____


☐ Slab ☑ Crawl Space ☐ Basement w/plumbing ☐ Basement wo/plumbing

Water Supply: ☐ Individual ☑ Community ☐ Public


Comments: Replaces Developer Permit issued 3-4-95

Comments: 6/14/95 As installed meets Dept. specifications

INITIAL SITE SKETCH

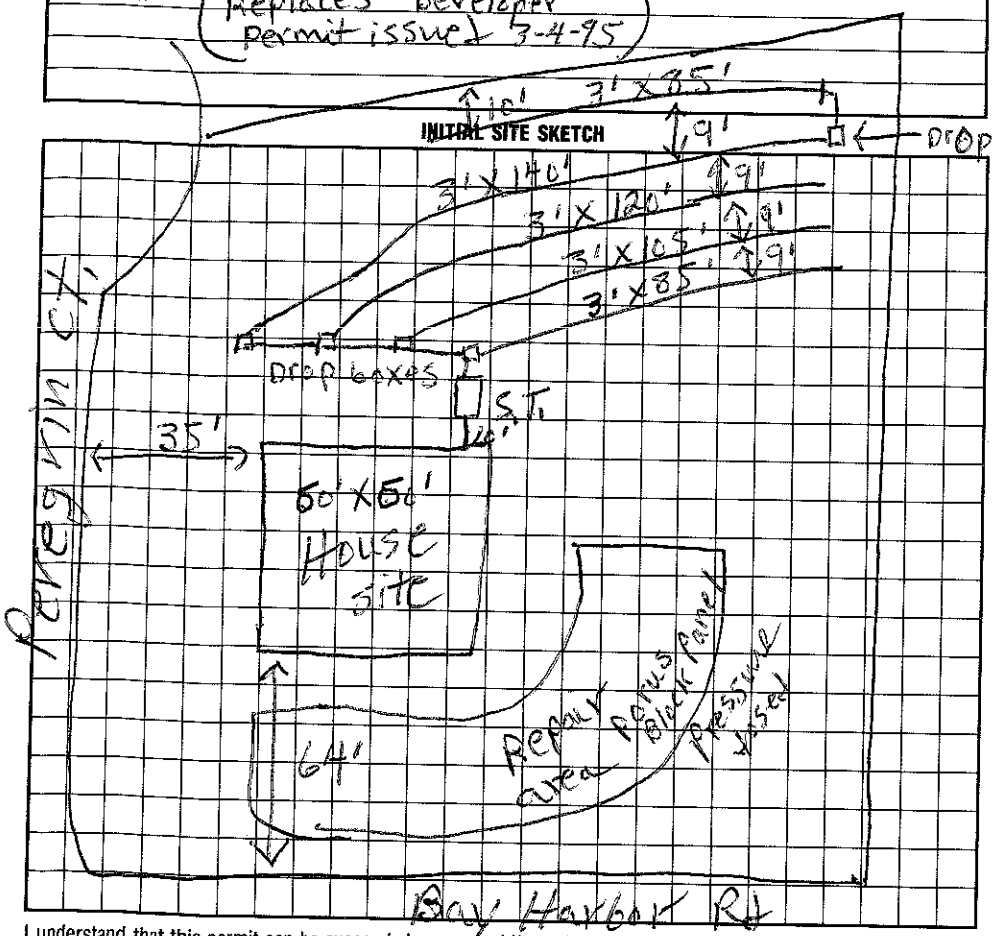

AS BUILT SKETCH

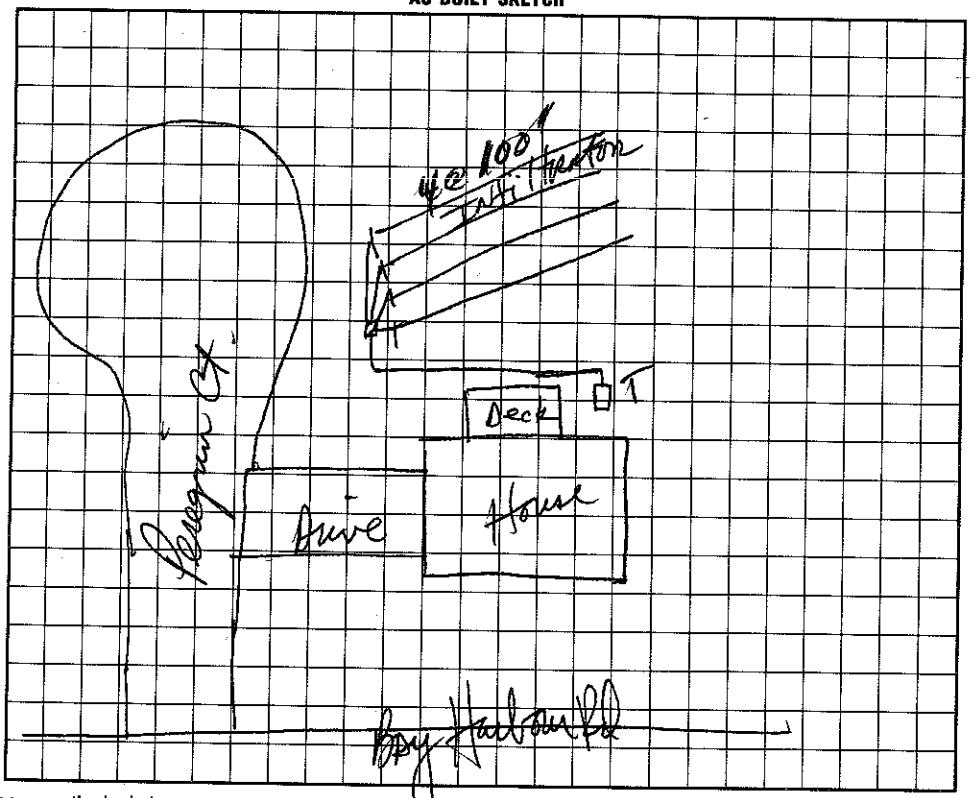

I understand that this permit can be suspended or revoked if any false information is supplied toward securing the permit/any unauthorized changes are made to the site/any unauthorized changes are made in the installation of the system. Improvement Permit is valid for 60 months from date of issuance.

Signed: X Jeff Cawley

Improvement Permit by: W. C. Moore date 3-22-95

Existing System Inspection by: _____ date _____

Installed by: Barry Thompson

Certificate of Completion by: _____ date _____

Operation Permit by: _____ date 7-12-95

HEALTH DEPT. COPY: WHITE INSPECTION COPY (FINAL): GREEN OWNER COPY (FINAL): YELLOW INSPECTION COPY (INITIAL): PINK OWNER COPY (INITIAL): GOLD