IREDELL COUNTY HEALTH DEPARTMENT / Authorization to Construct

STATESVILLE 704-878-5305 MOORESVILLE 704-664-5281

IMPROVEMENT PERMIT / ~~CERTIFICATE OF COMPLETION~~ / OPERATION PERMIT / EXISTING SYSTEM INSPECTION

PROPERTY DESCRIPTION NO. 18987 DATE 1/19/96 TAX MAP NO. Pt of 2C A 3 Watershed: X Yes ☐ No

OWNER OR CONTRACTOR Sunsay Builders PHONE: Business 892-0666 ~~Home~~ 4626-50-2663

ADDRESS PO Box 176 Davidson, NC 28036

LOCATION Brawley Sch TR on Bay Harbour TL on Pine Cliff Ln. (L) corner lot

SUBDIVISION Harbour BLOCK / SECTION 1/C LOT 78 LOT AREA .55 SITE CLASS PS DESIGN FLOW 480 L.T.A.R. .3

Septic Tank: 1000 Gallons; STB 794 Date 10/13/96
Pump Tank: ____ Gallons; PT ____ Date ____
Pump Make: ____ Model ____ Serial No. ____
Nitrification Field: No Fields 1 Square Feet 1600 Linear Feet 400*
No Lines 6 Trench Width 36" Max Trench Bottom Depth 24" Gravel Depth SAND.

X New System ☐ Repair System Type: I, II, (III), IV, V, VI
System Description: Drop distributor
Repair System Description: ____
Maintenance Agreement Required: ☐ Yes X No


X House/Mod. Home No. Bedrooms 4
☐ Mobile Home No. Bathrooms 3
☐ Business No. Employees ____
☐ Other ____
☐ Slab ☐ Crawl Space X Basement w/plumbing ☐ Basement wo/plumbing

Water Supply:
☐ Individual
X Community
☐ Public

Comments: * Gravity dist. box type III system
Flow divider before two D/B's set as shown here.

Comments: Installed as shown on Auth. Const.

INITIAL SITE SKETCH

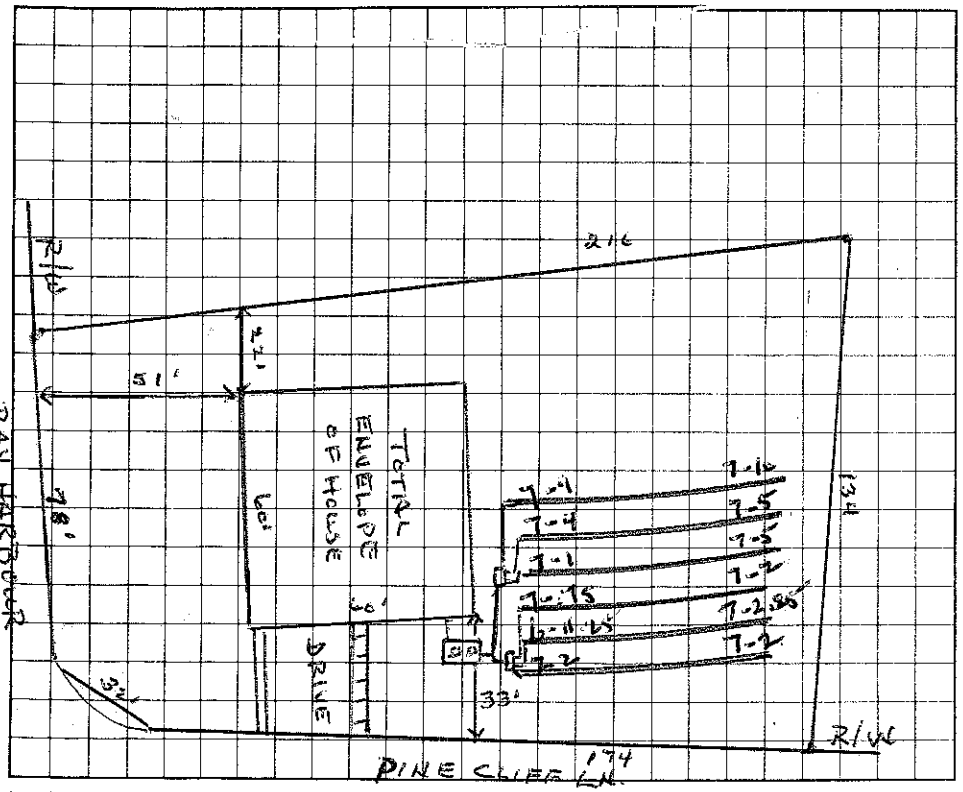

1" = 50'

AS BUILT SKETCH

I understand that this permit can be suspended or revoked if any false information is supplied toward securing the permit/any unauthorized changes are made to the site/any unauthorized changes are made in the installation of the system.

Signed: Jeff Conrady

Improvement Permit by: Wesley Sparks RS. date 1/19/96

Authorization to Construct by: Wesley Sparks RS. date 1/19/96

Installed by: R L Macleod

Certificate of Completion by: ____ date ____

Operation Permit by: Wesley Sparks RS. date 2/7/97

HEALTH DEPT. COPY: WHITE INSPECTION COPY (FINAL): GREEN OWNER COPY (FINAL): YELLOW INSPECTION COPY (INITIAL): PINK OWNER COPY (INITIAL): GOLD