4626 50 3150

IREDELL COUNTY HEALTH DEPARTMENT

AUTHORIZATION TO CONSTRUCT

STATESVILLE 704-878-5305 MOORESVILLE 704-664-5281

IMPROVEMENT PERMIT / ~~CERTIFICATE OF COMPLETION~~ / OPERATION PERMIT / EXISTING SYSTEM INSPECTION

PROPERTY DESCRIPTION NO. 18478 DATE Oct 31, '94 (Stuessy Burbank) TAX MAP NO. part of 2FC5 Watershed: ☑ Yes ☐ No EV

OWNER OR CONTRACTOR Crescent Resources c/o PHONE: Business _____ Home _____

ADDRESS PO Box 1003 Charlotte

LOCATION 1100 TR Bay Harbour Dr. TL Peregrin Ct. 3rd lot on Rt.

SUBDIVISION The Harbour BLOCK / SECTION MAP C LOT 61 LOT AREA 25,000 ± Feet SITE CLASS PSpt. 1936 DESIGN FLOW 360 gpd L.T.A.R. .3

Septic Tank: 1000 Gallons; STB 794 Date 2/14/96

Pump Tank: _____ Gallons; PT _____ Date _____

Pump Make: _____ Model _____ Serial No. _____

Nitrification Field: No Fields 1 Square Feet 1600 Linear Feet 200 266

No Lines 3 Trench Width 24" Max Trench Bottom Depth 36" Gravel Depth NA

☑ New System ☐ Repair System Type: I, II, III, IV, V, VI

System Description: gravity PPBRS

Repair System Description: Same

Maintenance Agreement Required: ☐ Yes ☑ No

☑ House/Mod. Home No. Bedrooms ~~3~~ 4

☐ Mobile Home No. Bathrooms 3

☐ Business No. Employees ____

☐ Other _____

☐ Slab ☑ Crawl Space ☐ Basement w/plumbing ☐ Basement wo/plumbing


Water Supply: ☐ Individual ☑ Community ☐ Public

Comments: Follow conditions w/ Variance.

Comments:

INITIAL SITE SKETCH

10/3/95 AWS

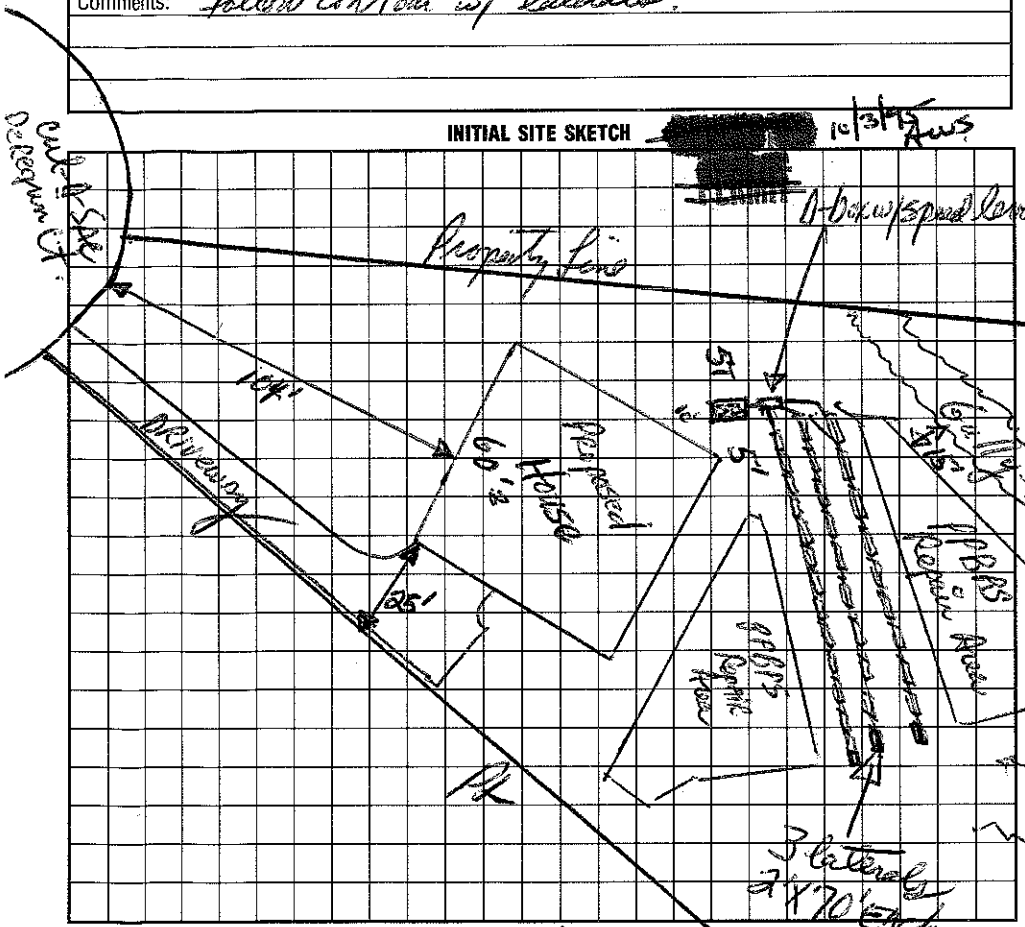

AS BUILT SKETCH

I understand that this permit can be suspended or revoked if any false information is supplied toward securing the permit/any unauthorized changes are made to the site/any unauthorized changes are made in the installation of the system. Improvement ~~Permit~~ is valid for 60 months from date of issuance.

AUTHORIZATION TO CONSTRUCT VALID 5 YEARS FROM ISSUE DATE. IMPROVEMENT PERMIT BECOMES ~~EXPIRES~~ EXPIRATION DATE.

Signed: _____ date 10/31/94

Improvement Permit by: _____ date 10/31/94

Existing System Inspection by: _____ date 10/3/95

Installed by: _____ date _____

Operation Permit by: _____ date 4/8/96

HEALTH DEPT. COPY: WHITE INSPECTION COPY (FINAL): GREEN OWNER COPY (FINAL): YELLOW INSPECTION COPY (INITIAL): PINK OWNER COPY (INITIAL): GOLD