IREDELL COUNTY HEALTH DEPARTMENT

STATESVILLE 704-878-5305 MOORESVILLE 704-664-5281

IMPROVEMENT PERMIT / CERTIFICATE OF COMPLETION / OPERATION PERMIT / EXISTING SYSTEM INSPECTION

PROPERTY DESCRIPTION NO. 19821 DATE Nov 30, '94 TAX MAP NO. part of 2043 Watershed: ☑ Yes ☐ No

OWNER OR CONTRACTOR Stanley Burbank PHONE: Business 892-0660 ~~Home~~ 4626-50-4483 WSIV

ADDRESS PO Box 176 Davidson, NC

LOCATION 1100 TR Bay Harbour Dr. on left @ jct w/ Peregrine Ct.

SUBDIVISION The Harbour BLOCK / SECTION 1 LOT 59 LOT AREA 27,796 SITE CLASS PS pr 1956 DESIGN FLOW 360 gpd L.T.A.R. .3

Septic Tank: 1000 Gallons; STB 794 Kellings Date 12-14-94

Pump Tank: _____ Gallons; PT _____ Date _____

Pump Make: _____ Model _____ Serial No. _____

Nitrification Field: No Fields 1 Square Feet 1200 Linear Feet 400

No Lines 5 Trench Width 36" Max Trench Bottom Depth 36" Gravel Depth 12"

☑ New System ☐ Repair System Type: I, II, III, IV, V, VI

System Description: gravity conventional

Repair System Description: ~~gravity~~ PPBPS

Maintenance Agreement Required: ☐ Yes ☑ No

☑ House/Mod. Home No. Bedrooms 3

☐ Mobile Home No. Bathrooms 2.5

☐ Business No. Employees _____

☐ Other _____


☐ Slab ☑ Crawl Space ☐ Basement w/plumbing ☐ Basement wo/plumbing

Water Supply: ☐ Individual ☑ Community ☐ Public


Comments:

Comments: 4/6/95 OK to use 300 gpd Jet filtration

INITIAL SITE SKETCH

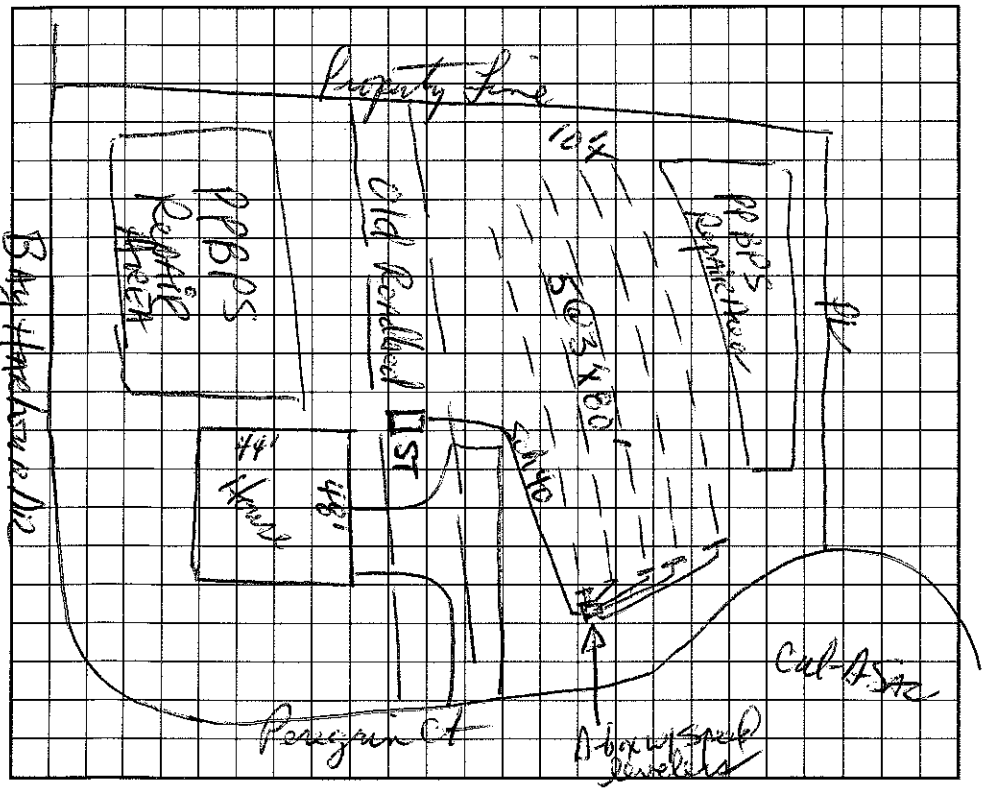

AS BUILT SKETCH

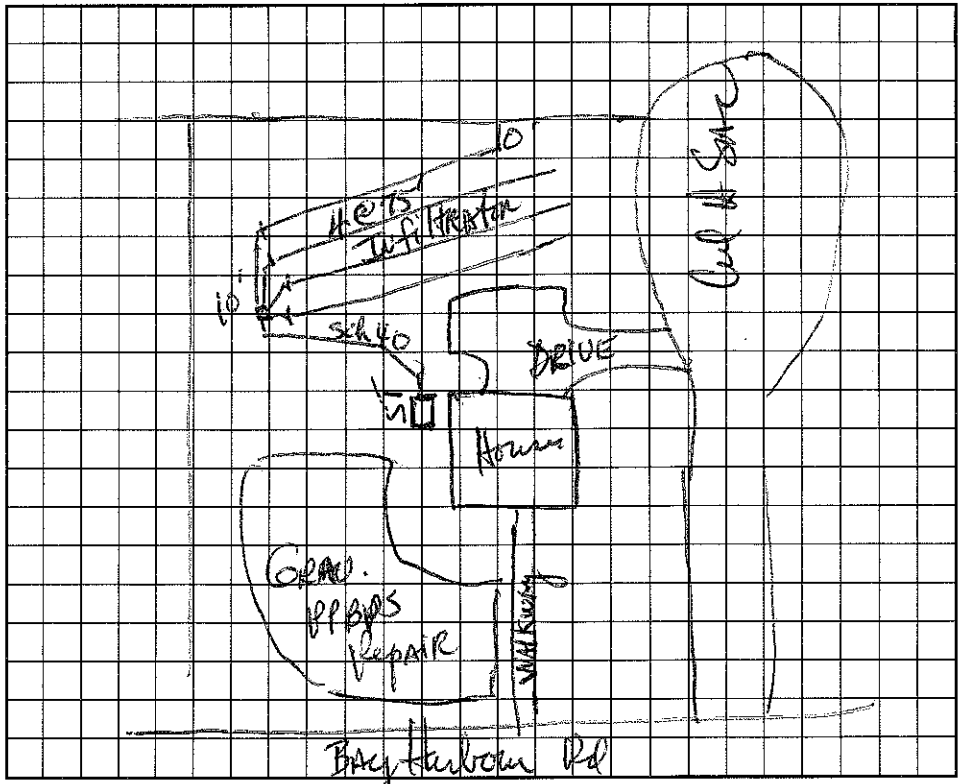

4 - TOGR 1100

I understand that this permit can be suspended or revoked if any false information is supplied toward securing the permit/any unauthorized changes are made to the site/any unauthorized changes are made in the installation of the system. Improvement Permit is valid for 60 months from date of issuance.

Signed: _____

Improvement Permit by: J R Hunsucker, RS date 11/30/94

Existing System Inspection by: _____ date _____

Installed by: Barry Thompson

Certificate of Completion by: _____ date _____

Operation Permit by: J R Hunsucker, RS date 4/19/95

HEALTH DEPT. COPY: WHITE INSPECTION COPY (FINAL): GREEN OWNER COPY (FINAL): YELLOW INSPECTION COPY (INITIAL): PINK OWNER COPY (INITIAL): GOLD