IREDELL COUNTY HEALTH DEPARTMENT

Addition to Contract

STATESVILLE 704-878-5305 MOORESVILLE 704-664-5281

IMPROVEMENT PERMIT / ~~CERTIFICATE OF COMPLETION~~ / OPERATION PERMIT / EXISTING SYSTEM INSPECTION

PROPERTY DESCRIPTION NO. _____ DATE 1/22/97 TAX MAP NO. 2F 12A 86 Watershed: ☒ Yes ☐ No

OWNER OR CONTRACTOR Sammy Burbank PHONE: Business 892-0660 ~~Home~~ 4626-50-4616

ADDRESS PO Box 176 Denedon, NC. 28036

LOCATION Big Harbour Rd. Intersection of Pine Cliff Ln.

SUBDIVISION Harbour BLOCK / SECTION 1 ~~HC~~ LOT 86 LOT AREA .52 SITE CLASS. PS DESIGN FLOW 480 L.T.A.R. .3

Septic Tank: EXISTING Gallons; STB _____ Date _____

Pump Tank: _____ Gallons; PT _____ Date _____

Pump Make: _____ Model _____ Serial No. _____

Nitrification Field: No Fields 1 Square Feet 720 Linear Feet 240 *

No Lines 2 Trench Width 36" Max Trench Bottom Depth 30" Gravel Depth SAND

☐ New System ☒ Repair System Type: I, II, ⓘ IV, V, VI

System Description: * CH PLASTIC

Repair System Description: CH PLASTIC

Maintenance Agreement Required: ☐ Yes ☐ No

☒ House/Mod. Home No. Bedrooms 4

☐ Mobile Home No. Bathrooms 3

☐ Business No. Employees _____

☐ Other _____


☐ Slab ☒ Crawl Space ☐ Basement w/plumbing ☐ Basement wo/plumbing

Water Supply:
☐ Individual
☒ Community
☐ Public


Comments: Set Bell Run Valve between Tank and Dist Box - SCH 40 PVC to Drop Boxes
* Utilities must be located inside yard where repair is installed

Comments: 550 FT² ORIGINAL
720 FT² REPAIR
1270

INITIAL SITE SKETCH

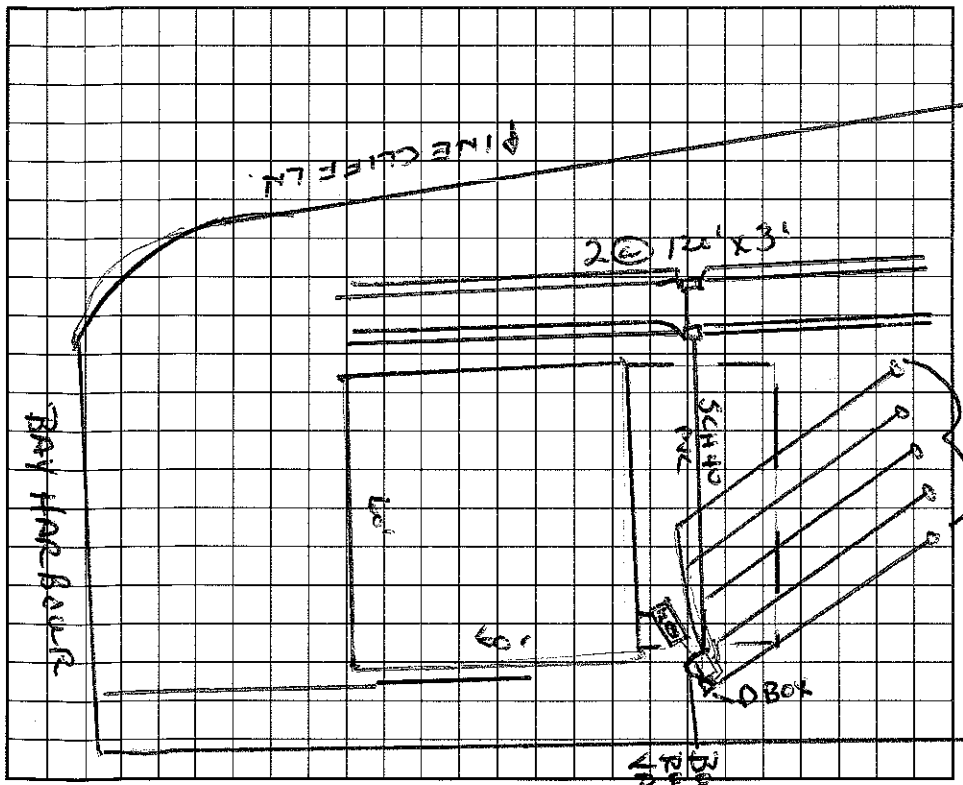

AS BUILT SKETCH

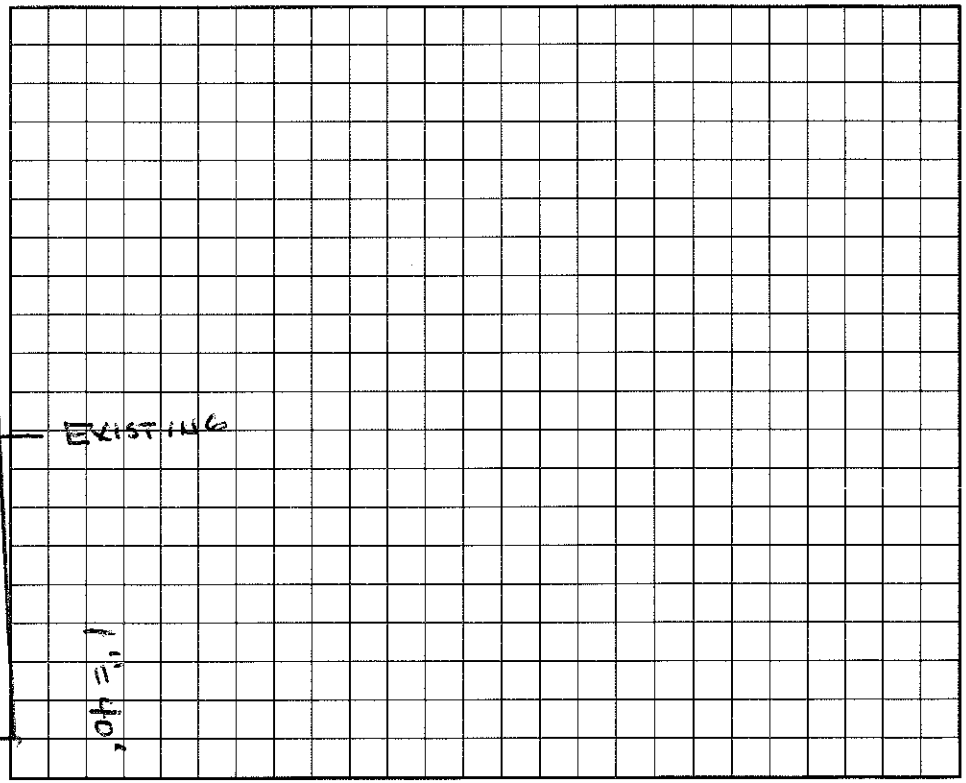

I understand that this permit can be suspended or revoked if any false information is supplied toward securing the permit/any unauthorized changes are made to the site/any unauthorized changes are made in the installation of the system. Improvement Permit is valid for 60 months from date of issuance.

Signed: _____ Installed by: MacLeod Const. Co.

Improvement Permit by: _____ date _____ Certificate of Completion by: _____ date _____

Existing System Inspection by: Wesley Sparks RS. date 1/22/97 Operation Permit by: Wesley Sparks RS. date 2/14/97

Accepted

HEALTH DEPT. COPY: WHITE INSPECTION COPY (FINAL): GREEN OWNER COPY (FINAL): YELLOW INSPECTION COPY (INITIAL): PINK OWNER COPY (INITIAL): GOLD

IREDELL COUNTY HEALTH DEPARTMENT / thru section to Construct

STATESVILLE 704-878-5305 MOORESVILLE 704-664-5281

IMPROVEMENT PERMIT / ~~CERTIFICATE OF COMPLETION~~ / OPERATION PERMIT / EXISTING SYSTEM INSPECTION

PROPERTY DESCRIPTION NO. 22974 DATE 1/30/96 TAX MAP NO. 2F 12 A 86 Watershed: X Yes ☐ No

OWNER OR CONTRACTOR Jaussy Burbank PHONE: Business 892-0660 Home

ADDRESS PO Box 176 Davidson, NC 28036

LOCATION Brawley Sch TR Bay Harbour TR Pine Cliff Ln. (R) corner lot

SUBDIVISION Harbour BLOCK / SECTION 1 LOT 86 LOT AREA .52 Ac SITE CLASS PS DESIGN FLOW 480 L.T.A.R. .3

Septic Tank: 1000 Gallons; STB Date

Pump Tank: 1000 Gallons; PT Date

Pump Make: Model Serial No. 395

Nitrification Field: No Fields 1 Square Feet 1600 Linear Feet ~~266~~

No Lines ~~4~~ 5 Trench Width 24" Max Trench Bottom Depth 36"

X New System ☐ Repair System Type: I II III IV V VI

System Description: Pres-16" Prefab. Panel Block

Repair System Description: Same

Maintenance Agreement Required: X Yes ☐ No

Gravel Depth SAND

X House/Mod. Home ☐ Mobile Home ☐ Business ☐ Other

No. Bedrooms 4 No. Bathrooms 2.5 No. Employees


☐ Slab X Crawl Space ☐ Basement w/plumbing ☐ Basement wo/plumbing

Water Supply: ☐ Individual X Community ☐ Public

Comments:

Comments: dry fall at pinthout pumping - Gravity Panel.

INITIAL SITE SKETCH

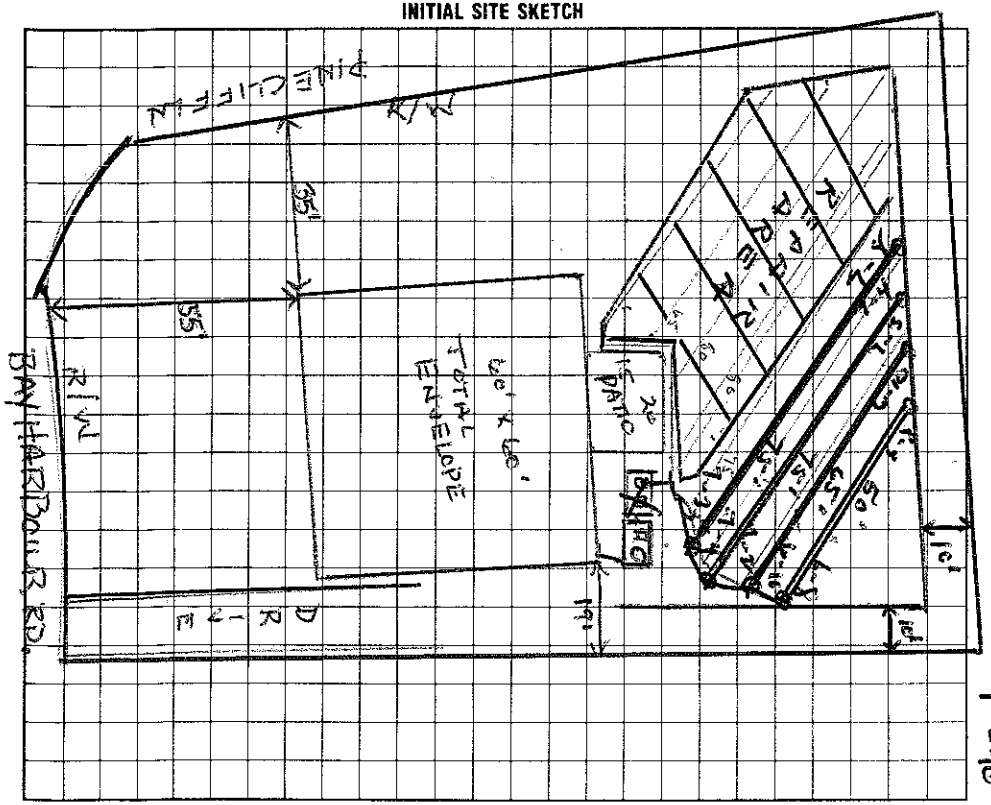

AS BUILT SKETCH

I understand that this permit can be suspended or revoked if any false information is supplied toward securing the permit/any unauthorized changes are made to the site/any unauthorized changes are made in the installation of the system.

Signed: X

Improvement Permit by: Wesley Sparks RS. date 1/30/96

Existing System Inspection by: Wesley Sparks RS. date 1/30/96

Installed by: Barry Thompson

Certificate of Completion by: date

Operation Permit by: Wesley Sparks RS. date 1/30/96

Authorized Agent

HEALTH DEPT. COPY: WHITE INSPECTION COPY (FINAL): GREEN OWNER COPY (FINAL): YELLOW INSPECTION COPY (INITIAL): PINK OWNER COPY (INITIAL): GOLD