IREDELL COUNTY HEALTH DEPARTMENT / Authorization to Construct

STATESVILLE 704-878-5305 MOORESVILLE 704-664-5281

IMPROVEMENT PERMIT / ~~CERTIFICATE OF COMPLETION~~ / OPERATION PERMIT / EXISTING SYSTEM INSPECTION

PROPERTY DESCRIPTION NO. 22972 DATE 1/27/96 TAX MAP NO. 2F 12A 85 4626504871 Watershed: X Yes ☐ No

OWNER OR CONTRACTOR Sunny Burbank PHONE: Business 892-0660 Home

ADDRESS PO Box 176 Davidson, NC. 28036

LOCATION Brawley Sch TR Bay Harbour TR Pine Clyffe Ln., 1st lot on R

SUBDIVISION Harbour BLOCK / SECTION 1 LOT 85 LOT AREA .69 SITE CLASS PS DESIGN FLOW 480 L.T.A.R. .35

Septic Tank: 1000 Gallons; STB 744 Date 10/6/96

Pump Tank: 1000 Gallons; PT 27 Date 10/7/96

Pump Make: LIBERTY Model 51-HA Serial No.

Nitrification Field: No Fields 1 Square Feet 1371 Linear Feet *345

No Lines X04 Trench Width 36" Max Trench Bottom Depth 36 Gravel Depth N/A

X New System ☐ Repair System Type: I II III IV V VI

System Description: Pres-infiltrator

Repair System Description: Same

Maintenance Agreement Required: ☐ Yes X No

X House/Mod. Home No. Bedrooms 4

☐ Mobile Home No. Bathrooms 2.5

☐ Business No. Employees

☐ Other


☐ Slab X Crawl Space ☐ Basement w/plumbing ☐ Basement wo/plumbing

Water Supply: ☐ Individual X Community ☐ Public


Comments: Approx. 135 gals per dose maximum
Gate valve set in Washer box as well as inside pump tank.

Comments: LINES & TANKS CHECKED - 11/20/96 - CBF
Added 24' to drain line closest to house

INITIAL SITE SKETCH

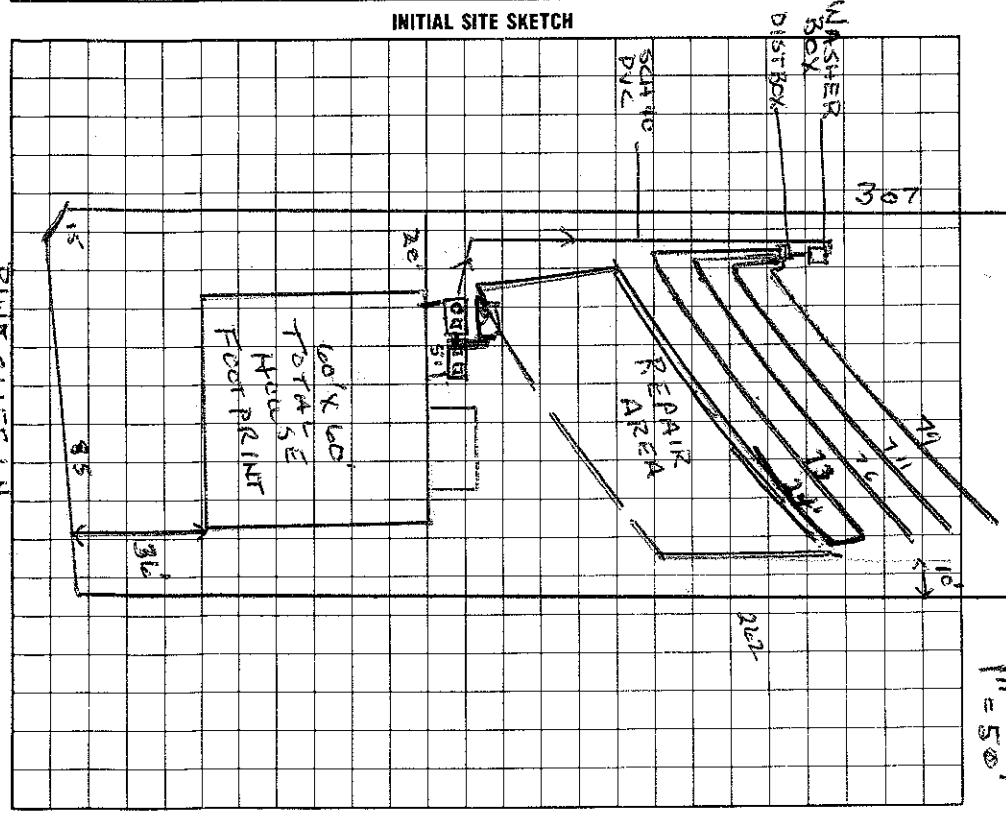

AS BUILT SKETCH

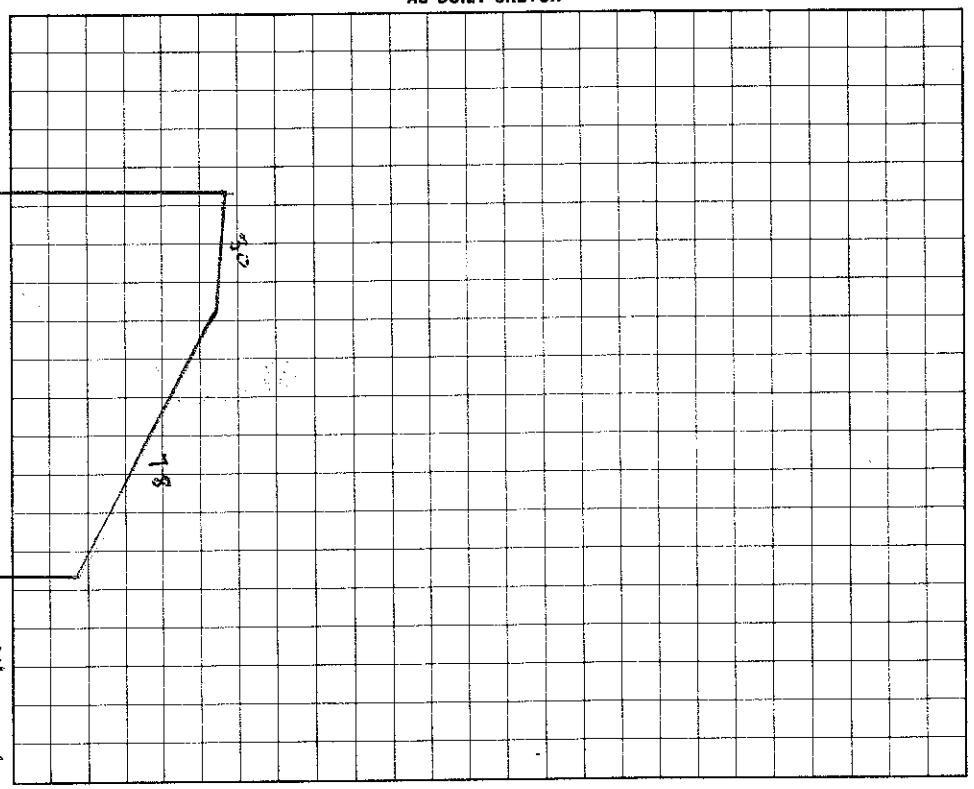

I understand that this permit can be suspended or revoked if any false information is supplied toward securing the permit/any unauthorized changes are made to the site/any unauthorized changes are made in the installation of the system.

Auth. to Construct valid five years. Subsq. Permit no time limit.

Signed: X

Improvement Permit by: Wesley Sparks RS. date 1/27/96

Existing System Inspection by: Wesley Sparks RS. date 1/27/96

Installed by: McLeod Const.

Certificate of Completion by: date

Operation Permit by: Wesley Sparks RS. date 12/17/96

HEALTH DEPT. COPY: WHITE INSPECTION COPY (FINAL): GREEN OWNER COPY (FINAL): YELLOW INSPECTION COPY (INITIAL): PINK OWNER COPY (INITIAL): GOLD