IREDELL COUNTY HEALTH DEPARTMENT
ENVIRONMENTAL HEALTH DIVISION
Application For Improvement Permit

ALL items on this application form must be completed before Health Department can begin work. One application must be completed by the property owner or agent for each (proposed) site.

PERSONAL INFORMATION:

Applicant	Phone #	Mailing Address	City	State	Zip Code
Saussy Burbank	896-0568	P.O. Box 176	Davidson	N.C.	28036
Current Property Owner		Mailing Address	City	State	Zip Code

PROPERTY INFORMATION:

(Proposed) Subdivision Name	(Proposed) Lot #	(Proposed) Block/Section #	State Road #
The Harbour	85		

(Proposed) Water Supply: Public, Private Well	**Preliminary Plat Approval Date** (DEVELOPERS ONLY)	Tax Map #
Community Well - Public		2F-12-A-85

Specific Directions to Property Off Brawley School Rd - Right on Barn Harbour - Right on Pine Cliff Lane, 1st ~~lot~~ on Right
112 Pine Cliff ~~Lane~~ Lane

TYPE OF FACILITY: (use check (X) or number as appropriate)

House ✓ Mobile Home _____ Commercial _____ No. Bedrooms 4 No. Baths 2.5

No. Persons or Employees (commercial only) _____ Basement _____ Basement with Plumbing _____


Crawl Space ✓ Concrete Slab _____ Garbage Disposal ✓ Jaccuzi or spa _____

COVENANT AND SIGNATURE:

I hereby make application to the Iredell County Health Department for a soils/site evaluation of the property described above. This evaluation is to be conducted for the sole purpose of obtaining a septic system Improvement Permit. I hereby authorize Iredell County Health Department representatives to go onto the above property for purposes of conducting this evaluation. I understand that, by state law, any Improvement Permit issued on the above property may be voided if substantial changes are made to the designated sewage system site. The issuance of an Improvement Permit by the Iredell County Health Department does not relieve me from compliance with all other relevant state/local laws or regulations. As owner or authorized agent, I covenant that the contents of this application are true and represent the maximum facilities intended to be placed on this property to my knowledge to date.

I understand that any Improvement Permit issued on the above property is valid for five (5) years from the issuance date and is subject to revocation if the above described site plans or intended use changes.

1/5/96 DATE Ann Saussy SIGNATURE OF OWNER/AUTHORIZED AGENT

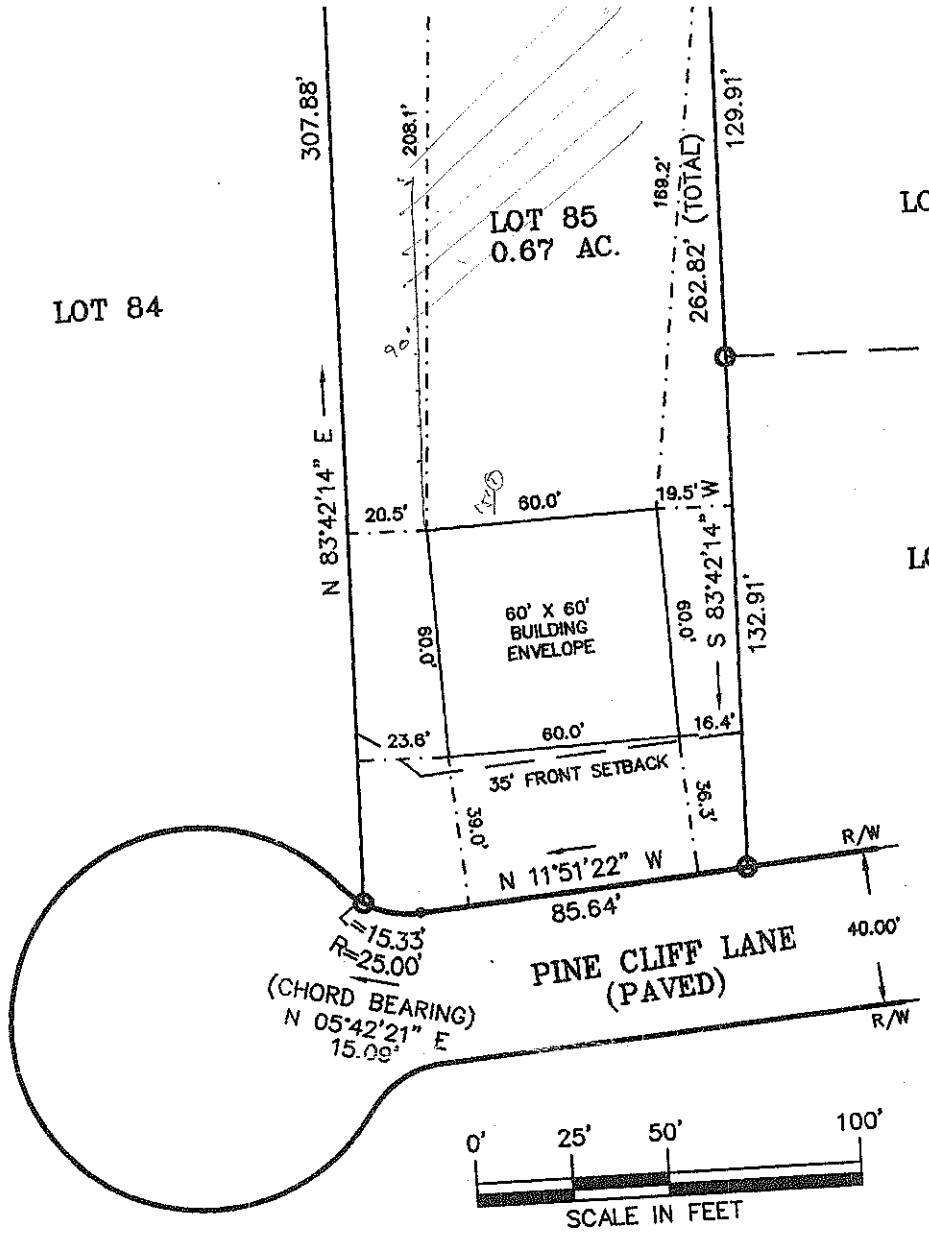

NOTES

1) THIS PROPERTY MAY BE SUBJECT TO ANY EASEMENTS AND/OR RIGHTS OF WAY OF RECORD.
2) ACREAGE COMPUTED BY THE COORDINATE METHOD.
3) UNDERGROUND POWER

SCALE 1" = 50'

ACQUIRED BY: SAUSSY BURBANK

PLOT PLAN SURVEY

OF

112 PINE CLIFF LANE

LOT 85 THE HARBOUR PHASE 1 MAP C

DAVIDSON TWSP., IREDELL CO., N.C.

LEGEND

P.P. = POWER POLE
□ = DUKE POWER TRANS.
E.I.P. = EXISTING IRON FOUND
I.P.S. = #4 REBAR SET
R/W = RIGHT-OF-WAY
(W) = WELL

FIELD BOOK:

FILE: 2483512

TAX MAP NO: