IREDELL COUNTY HEALTH DEPARTMENT

STATESVILLE 704-878-5305 MOORESVILLE 704-664-5281

IMPROVEMENT PERMIT / CERTIFICATE OF COMPLETION / OPERATION PERMIT / EXISTING SYSTEM INSPECTION

PROPERTY DESCRIPTION NO. 20154 DATE March 9, '95 TAX MAP NO. part of 2CA3 4626504974 Watershed: ☑ Yes ☐ No

OWNER OR CONTRACTOR Crescent Resources Inc Jerry Burleson PHONE: Business _____ Home _____ WSIV

ADDRESS PO Box 1003, Charlotte

LOCATION Bayley School Road TR Bay Harbour Rd. TR Pine Cliff Lane at end on Right

SUBDIVISION The Harbour BLOCK / SECTION _____ LOT 84 LOT AREA 30,000 +/- SITE CLASS. PS DESIGN FLOW 480gpd L.T.A.R. .3

Septic Tank: 1000 Gallons; STB 794 Date 12/19/95

Pump Tank: 1000 Gallons; PT 27 Date 12/Hi/95

Pump Make: Liberty Model LES1A Serial No. 3039

Nitrification Field: No Fields 1 Square Feet 1600 Linear Feet 534+

No Lines 5x3 Trench Width 36" Max Trench Bottom Depth 36" Gravel Depth 12"

☑ New System ☐ Repair System Type: I, II, III, IV, V, VI

System Description: pumped conventional

Repair System Description: Same or pumped Infiltrator

Maintenance Agreement Required: ☐ Yes ☑ No

☐ House/Mod. Home No. Bedrooms 4

☐ Mobile Home No. Bathrooms 3

☐ Business No. Employees _____

☐ Other _____


☐ Slab ☑ Crawl Space ☐ Basement w/plumbing ☐ Basement wo/plumbing

Water Supply: ☐ Individual ☑ Community ☐ Public


Comments: laterals to follow contour

Comments: Installed as drawn on Imp Permit

INITIAL SITE SKETCH

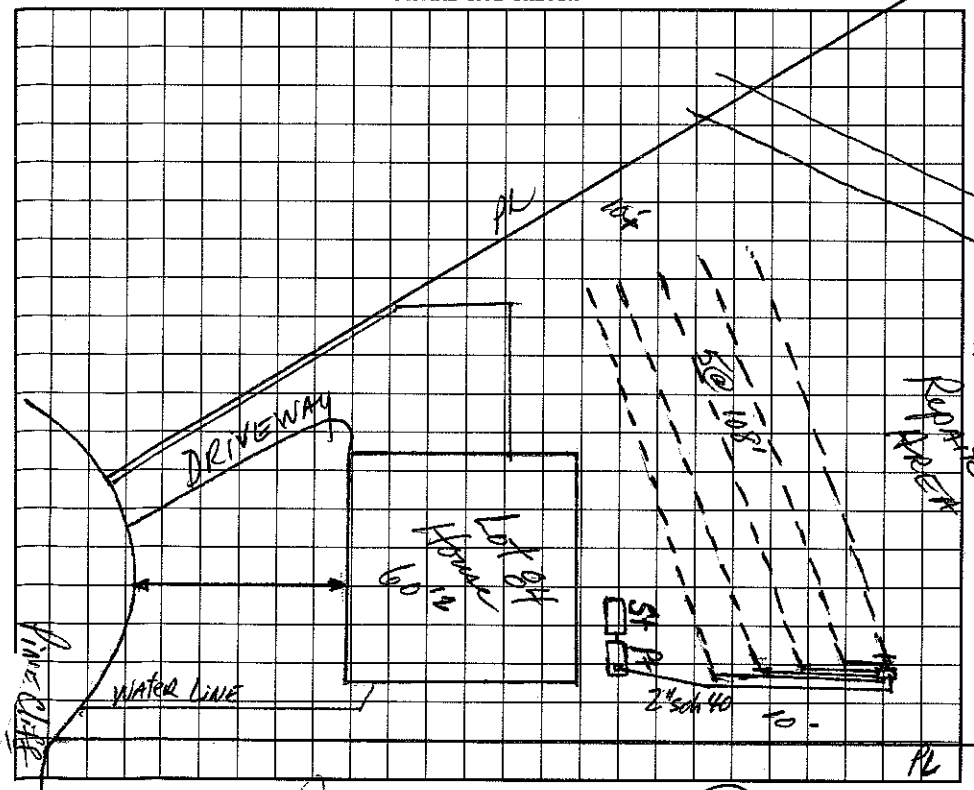

AS BUILT SKETCH

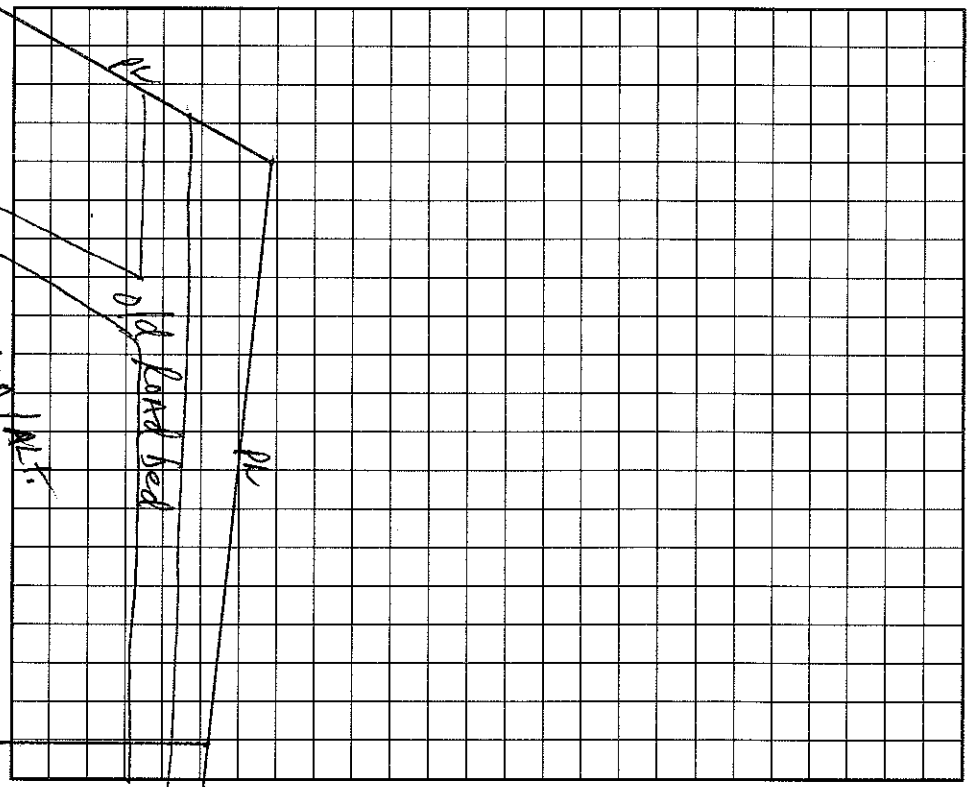

I understand that this permit can be suspended or revoked if any false information is supplied toward securing the permit/any unauthorized changes are made to the site/any unauthorized changes are made in the installation of the system. Improvement Permit is valid for 60 months from date of issuance.

Signed: _____

Improvement Permit by: Jack R. Fraser, RS date 3/9/95

Existing System Inspection by: _____ date _____

Installed by: Ben Thompson

Certificate of Completion by: Wesley Sparks R.S. date 3/21/96

Operation Permit by: Wesley Sparks R.S. date 3/21/96

HEALTH DEPT. COPY: WHITE INSPECTION COPY (FINAL): GREEN OWNER COPY (FINAL): YELLOW INSPECTION COPY (INITIAL): PINK OWNER COPY (INITIAL): GOLD