IREDELL COUNTY HEALTH DEPARTMENT

STATESVILLE 704-878-5305 280.00 Paid MOORESVILLE 704-664-5281

IMPROVEMENT PERMIT / AUTHORIZATION TO CONSTRUCT / OPERATION PERMIT / EXISTING SYSTEM INSPECTION

PERMIT# 107461 PIN# 4626-50-5136 DATE 7/16/02

OWNER OR CONTRACTOR William Heard PHONE: Business _____ Home _____

ADDRESS 1115 Peregrin Ct. Mooresville NC 28115

LOCATION Brawley Sch, TR Bay Harbor, TL Peregrin on Lt in Culdesac

SUBDIVISION Harbour BLOCK / SECTION 1 LOT 60 LOT AREA 1.34 Ac SITE CLASS. PS DESIGN FLOW 600 L.T.A.R. 0.3

Septic Tank: Existing Gallons: STB _____ Date _____

Pump Tank: _____ Gallons: PT _____ Date _____

Pump Make: _____ Model _____ Serial No. _____

Nitrification Field: No Fields 1 Square Feet 300 Linear Feet 160 Add'tion

No Lines 2@50' Trench Width 36" Max Trench Bottom Depth 36" Gravel Depth —

☐ New System ☐ Repair System Type: I, II, III, IV, V, VI

System Description Add'tion & 25% Reduction

Repair System Description: Pump Conventional

Maintenance Agreement Required: ☐ Yes ☒ No

☒ House/Mod. Home ☐ Mobile Home ☐ Business ☐ Other

No. Bedrooms 5 No. Bathrooms 2.5 No. Employees ____


☐ Slab ☑ Crawl Space ☐ Basement w/plumbing ☐ Basement wo/plumbing

Water Supply: ☐ Individual ☐ Public ☒ Community


Comments:/Conditions:

Comments:/Conditions:

INITIAL SITE SKETCH

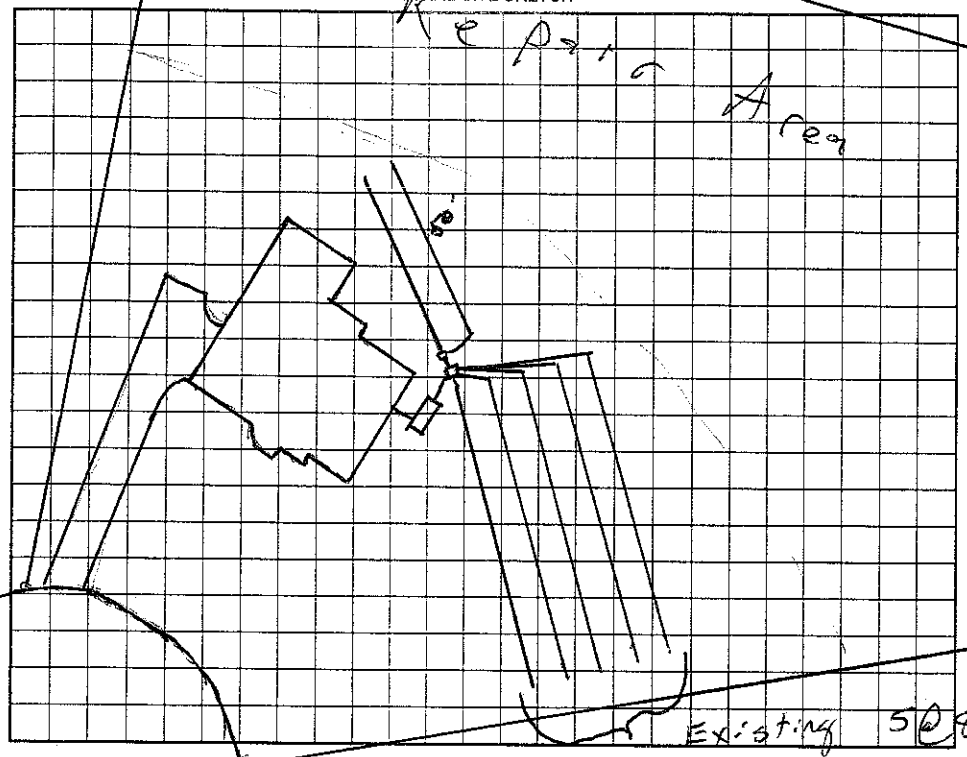

AS BUILT SKETCH

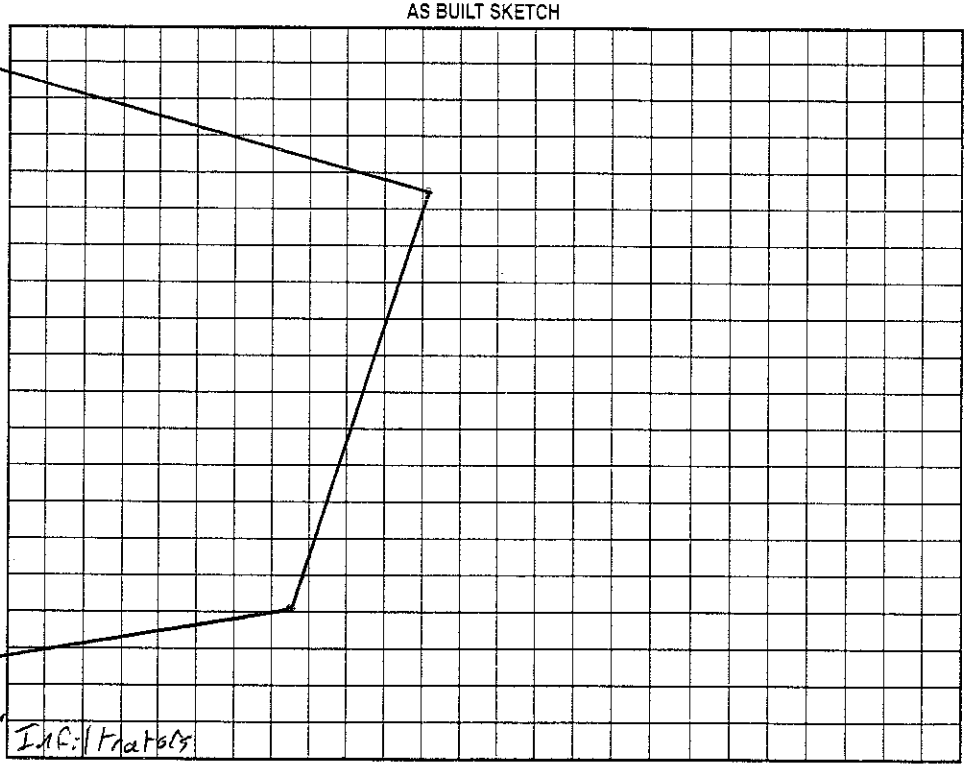

Permit can be suspended or revoked if any false information is supplied toward securing the permit/any unauthorized changes are made to the site/any unauthorized changes are made in the installation of the system. Improvement Permit with plat valid without expiration. Improvement Permit with site plan valid for sixty months. Authorization to Construct is valid for a period equal to that of Improvement Permit – not to exceed sixty months.

Signed: William Heard date 7/26/02 Installed by: Tim Simmons

Improvement Permit by: [signature] RS date 7/14/02 Operation Permit by: Wesley Sparks RS date 5/3/03

Authorization to Construct by: [signature] RS date 7/14/02 Existing System Inspection by: _____ date _____

HEALTH DEPT. COPY: WHITE OWNER COPY (FINAL): YELLOW OWNER COPY (INITIAL): PINK