IREDELL COUNTY HEALTH DEPARTMENT

Authorization to Construct

STATESVILLE 704-878-5305 MOORESVILLE 704-664-5281

IMPROVEMENT PERMIT / ~~CERTIFICATE OF COMPLETION~~ / OPERATION PERMIT / EXISTING SYSTEM INSPECTION

PROPERTY DESCRIPTION NO. 23343 DATE 4/12/96 TAX MAP NO. 2F-12-A-87 Watershed: ☒ ~~Yes~~ ☐ No

OWNER OR CONTRACTOR Sandy Burbank PHONE: Business 892-0660 ~~Home~~ 4626-50-5637

ADDRESS 6525 Morrison Blvd Suite 2H Charlotte

LOCATION #134 Harbor Rd - Barley School - Tk Bay Harbor Rd 7th lot on Right

SUBDIVISION Harbor BLOCK / SECTION 1 LOT 87 LOT AREA 21,780 SITE CLASS PS DESIGN FLOW 480gpd L.T.A.R. .39gpd/sf

Septic Tank: 1000 Gallons; STB 794 Date 7/5/96

Pump Tank: _____ Gallons; PT _____ Date _____

Pump Make: _____ Model _____ Serial No. _____

Nitrification Field: No Fields 1 Square Feet 1200 Linear Feet 400

No Lines 4 Trench Width 36" Max Trench Bottom Depth 36" Gravity Depth 17"

☒ New System ☐ Repair System Type: I, II, III, IV, V, VI

System Description: Gravity Conventional

Repair System Description: Parallel

Maintenance Agreement Required: ☐ Yes ☒ No

☒ House/Mod. Home No. Bedrooms 4

☐ Mobile Home No. Bathrooms 2.5

☐ Business No. Employees ____

☐ Other _____


☐ Slab ☒ Crawl Space ☐ Basement w/plumbing ☐ Basement wo/plumbing

Water Supply: ☐ Individual ☒ Community ☐ Public

Comments:

Comments:

INITIAL SITE SKETCH

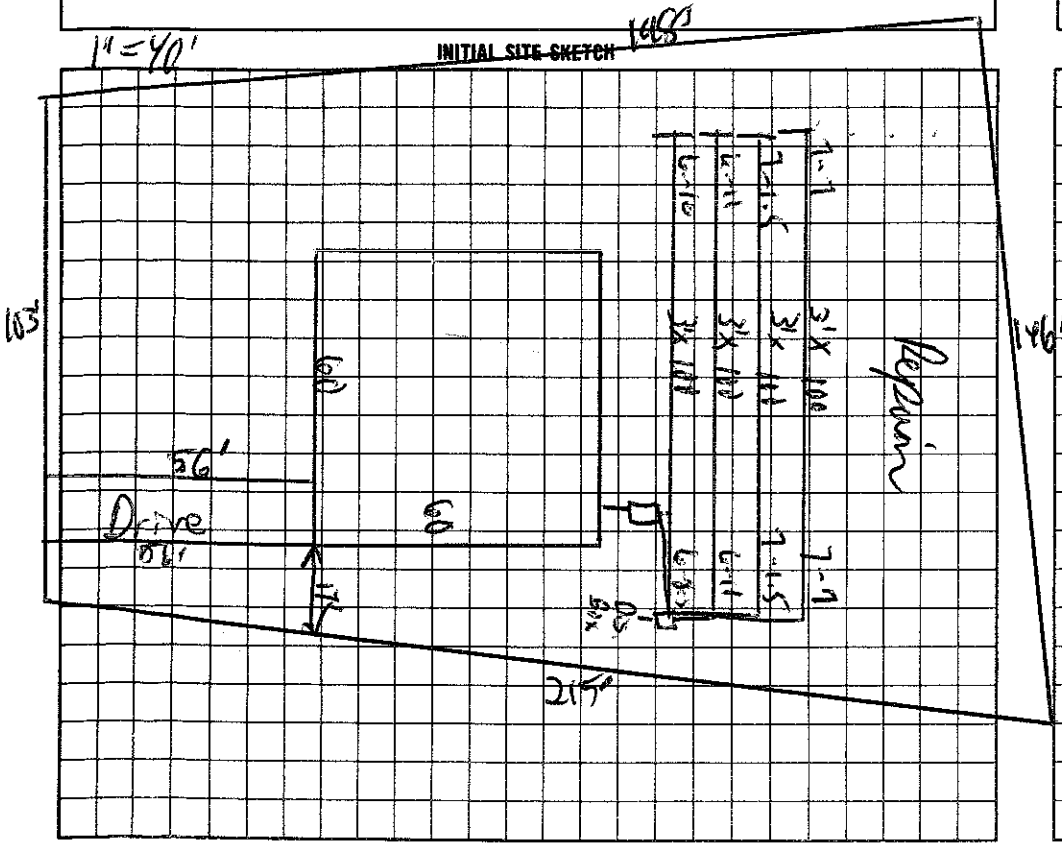

AS BUILT SKETCH

I understand that this permit can be suspended or revoked if any false information is supplied toward securing the permit/any unauthorized changes are made to the site/any unauthorized changes are made in the installation of the system.

Signed: x Ellen Shore

Improvement Permit by: C. Bob Thompson EHSI date 4/18/96

Existing System Inspection by: C. Bob Thompson EHSI date 4/18/96

Installed by: Machine Cast

Certificate of Completion by: _____ date _____

Operation Permit by: Wesley Sparks R.S. date 12/13/96

HEALTH DEPT. COPY: WHITE INSPECTION COPY (FINAL): GREEN OWNER COPY (FINAL): YELLOW INSPECTION COPY (INITIAL): PINK OWNER COPY (INITIAL): GOLD

Authorization to Construct is Valid for 60 months from Issue date