IREDELL COUNTY HEALTH DEPARTMENT

STATESVILLE 704-878-5305 | MOORESVILLE 704-664-5281

4602650 7241

IMPROVEMENT PERMIT / CERTIFICATE OF COMPLETION / OPERATION PERMIT / EXISTING SYSTEM INSPECTION

PROPERTY DESCRIPTION NO. 19770 DATE Dec 30, '94 TAX MAP NO. part of 2CA3 Watershed: ☑ Yes ☐ No

OWNER OR CONTRACTOR MI Homes PHONE: Business 376-9800 Home

ADDRESS 1043 E. Morehead #105

LOCATION Hwy 70 to Bay Harbour Dr. TL Sandpiper on Right

SUBDIVISION The Harbour BLOCK / SECTION 1 LOT 55 LOT AREA .62 ac SITE CLASS B pm 1956 1997 DESIGN FLOW 480 gpd L.T.A.R. .03

Septic Tank: 1000 Gallons; STB 794 Hellings Date 3-3-95

Pump Tank: 1000 Gallons; PT 27 Hellings Date 3-1-95

Pump Make: Model Serial No.

Nitrification Field: No Fields 1 Square Feet Linear Feet 267'

No Lines 4 Trench Width 24" Max Trench Bottom Depth 30-36" Gravel Depth NA

☑ New System ☐ Repair System Type: I, II, III, ☑ V, VI

System Description: LPPPBPS

Repair System Description: LPP

Maintenance Agreement Required: ☑ Yes ☐ No

☑ House/Mod. Home No. Bedrooms 4

☐ Mobile Home No. Bathrooms 3.5

☐ Business No. Employees

☐ Other


☐ Slab ☑ Crawl Space ☐ Basement w/plumbing ☐ Basement wo/plumbing

Water Supply: ☐ Individual ☑ Community ☐ Public


Comments: 62 panels total; ONE 3/16" hole per panel; 2' pressure head.

Comments: Septic Tank and pump tank set as shown. 11/11/95 Drainfield checked and level.

INITIAL SITE SKETCH

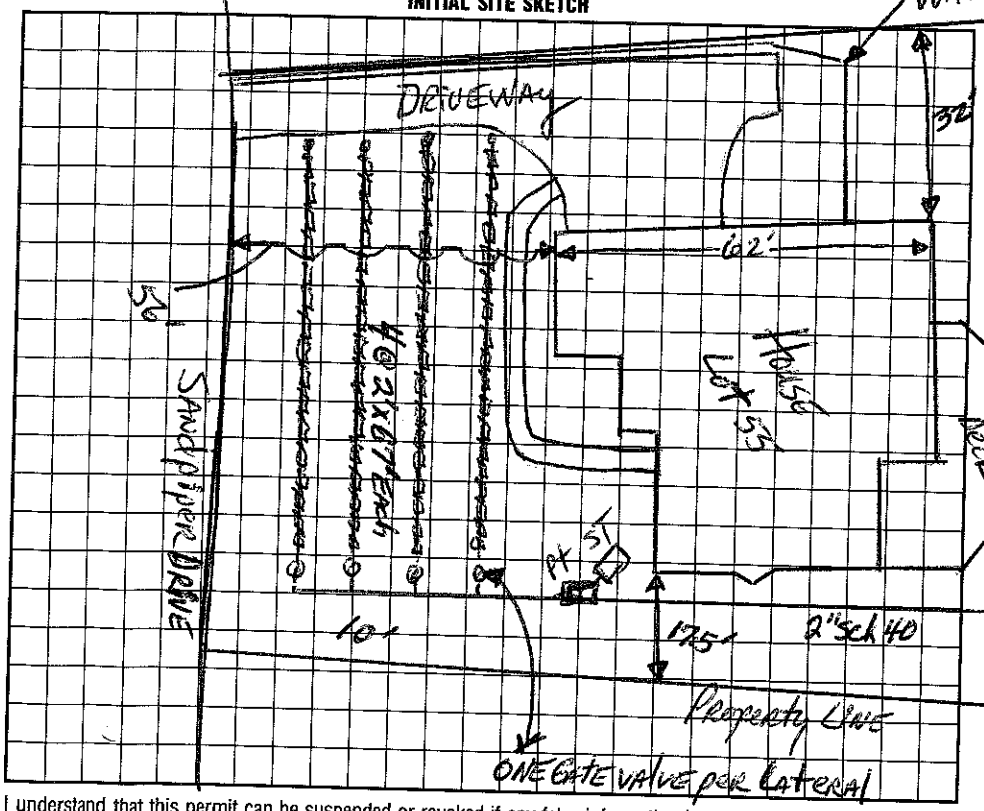

AS BUILT SKETCH

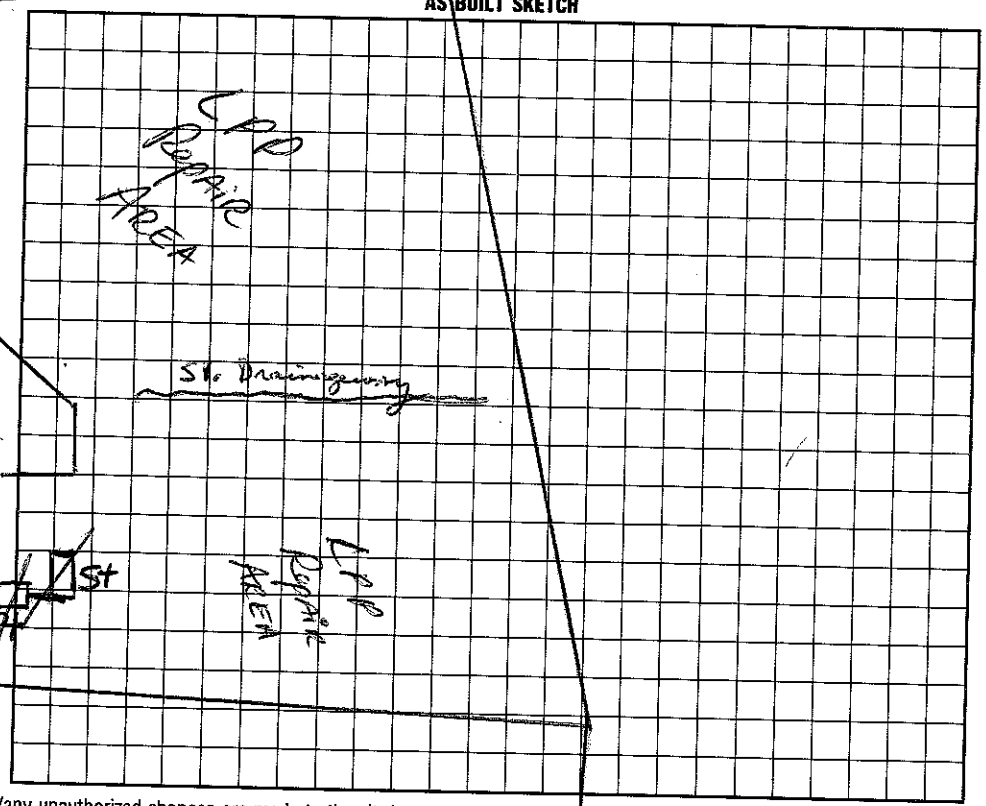

I understand that this permit can be suspended or revoked if any false information is supplied toward securing the permit/any unauthorized changes are made to the site/any unauthorized changes are made in the installation of the system. Improvement Permit is valid for 60 months from date of issuance.

Signed: [signature]

Improvement Permit by: Patrick R. Hinson, RS date 12/30/94

Existing System Inspection by: date

Installed by: R&R Morehead

Certificate of Completion by: [signature] RS date 1/11/02

Operation Permit by: date

HEALTH DEPT. COPY: WHITE | INSPECTION COPY (FINAL): GREEN | OWNER COPY (FINAL): YELLOW | INSPECTION COPY (INITIAL): PINK | OWNER COPY (INITIAL): GOLD