IREDELL COUNTY HEALTH DEPARTMENT

STATESVILLE 704-878-5305 MOORESVILLE 704-664-5281

IMPROVEMENT PERMIT / AUTHORIZATION TO CONSTRUCT / OPERATION PERMIT / EXISTING SYSTEM INSPECTION

PERMIT# 073561 PIN# 4626 50 8410 DATE 5/14/98

OWNER OR CONTRACTOR Dennis Burbank PHONE: Business 945-1515 Home

ADDRESS 517 Sharon Amity Suite 100 Charlotte, NC. 28211

LOCATION Bay Sch TR Bay Harbour TL Sandpiper Dr. on (R) corner

SUBDIVISION HARBOUR BLOCK / SECTION 1 LOT 57 LOT AREA .52 AC SITE CLASS. PS DESIGN FLOW 480 L.T.A.R. .3

Septic Tank: 1000 Gallons; STB 794 Date 10/1/98
Pump Tank: Gallons; PT Date
Pump Make: Model Serial No.
Nitrification Field: No Fields 1 Square Feet 1200* Linear Feet 400*
No Lines 4 Trench Width 36" Max Trench Bottom Depth 36"

☒ New System ☐ Repair System Type: I, II, (III) IV, V, VI
System Description: GRAV - CH PLASTIC - Typ 3
Repair System Description: GRAV - 16" PPBS
Maintenance Agreement Required: ☒ Yes ☐ No


☐ House/Mod. Home No. Bedrooms
☐ Mobile Home No. Bathrooms
☐ Business No. Employees
☐ Other
☐ Slab ☐ Crawl Space ☐ Basement w/plumbing ☐ Basement wo/plumbing

Water Supply: ☐ Individual ☐ Public ☐ Community

Comments:/Conditions: * 25% reduction for use of Type 3 Modified Drainfield material

Comments:/Conditions:

INITIAL SITE SKETCH

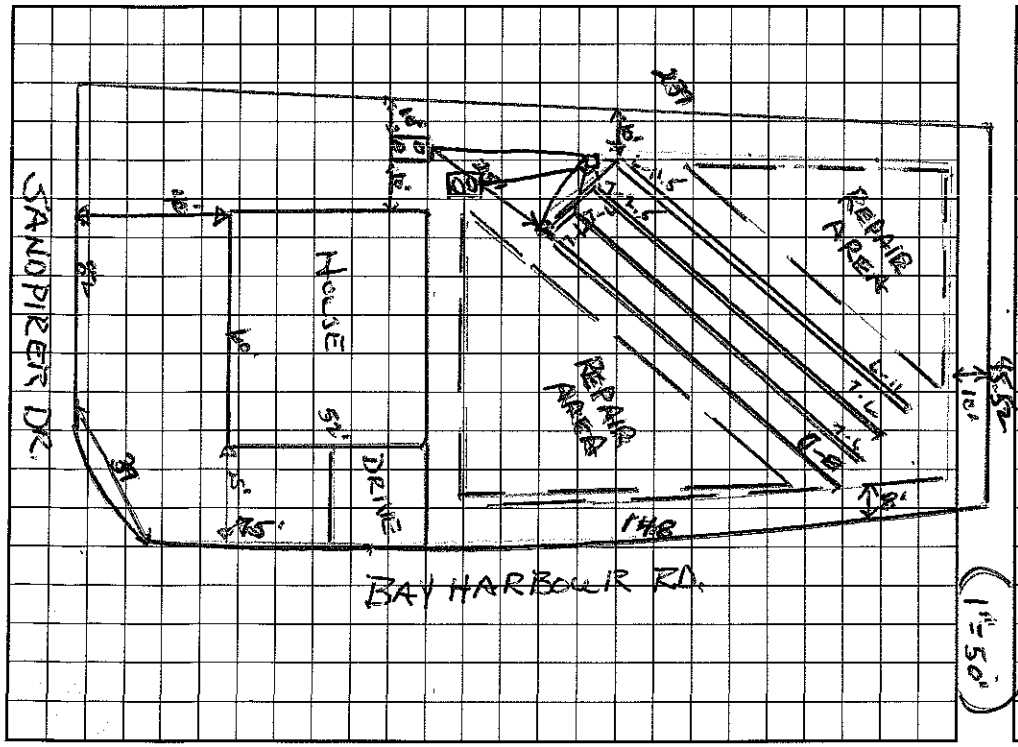

AS BUILT SKETCH

I understand that this permit can be suspended or revoked if any false information is supplied toward securing the permit/any unauthorized changes are made to the site/any unauthorized changes are made in the installation of the system. Improvement Permit with plat valid without expiration. Improvement Permit with site plan valid for sixty months. Authorization to Construct is valid for a period equal to that of Improvement Permit – not to exceed sixty months.

Signed: * date 6-5-98 Installed by: Macwood

Improvement Permit by: Wesley Sparks R.S. date 5/14/98 Operation Permit by: Wesley Sparks R.S. date 1/11/99

Authorization to Construct by: Wesley Sparks R.S. date 5/14/98 Existing System Inspection by: date

HEALTH DEPT. COPY: WHITE INSPECTION COPY (FINAL): GREEN OWNER COPY (FINAL): YELLOW INSPECTION COPY (INITIAL): PINK OWNER COPY (INITIAL): GOLD