IREDELL COUNTY HEALTH DEPARTMENT

STATESVILLE 704-878-5305 350.00 Paid MOORESVILLE 704-664-5281

IMPROVEMENT PERMIT / AUTHORIZATION TO CONSTRUCT / OPERATION PERMIT / EXISTING SYSTEM INSPECTION

PERMIT# N/A PIN# 4624-51-1098 DATE 2/14/07

OWNER OR APPLICANT Margaret McAlister PHONE: Business 704-902-6292 Home

ADDRESS 4750 Cambrone Dr. Denver, NC 28037

LOCATION 1100 TR Bay Harbour TR Pine Cliff Ln. to cul de sac; straight ahead

SUBDIVISION HARBOUR BLOCK / SECTION 1 MAP/LOT 61 LOT AREA 25000 SITE CLASS. RS DESIGN FLOW 480 L.T.A.R. .3

Septic Tank: EXISTING Gallons: STB Date

Pump Tank: Gallons: PT Date

Pump Make: Model Serial No.

Nitrification Field: No Fields 1 Square Feet 1200 Linear Feet 400

No Lines 4@100' Trench Width 3 Max Trench Bottom Depth 3' Gravel Depth No

☐ New System ☒ Repair ☐ Expansion System Type: I (II) III IV V VI

System Description:

Repair System Description: GRAV - 25% REDUCED

Maintenance Agreement Required: ☐ Yes ☒ No

☒ House/Mod. Home ☐ Mobile Home ☐ Business ☐ Other

No. Bedrooms 4 No. Persons No. Employees

Water Supply: ☐ Individual ☐ Public ☒ Community


☐ Gravity ☐ Pressure ☐ Slab ☒ Crawl Space ☐ Basement w/plumbing ☐ Basement wo/plumbing

Comments/Conditions: Bull Run Valve Required
Berme to be constructed above drainfield
Dist Box requires Speed Levelers


Comments/Conditions: OLD-2 NEW-1

(1" = 50')

INITIAL SITE SKETCH

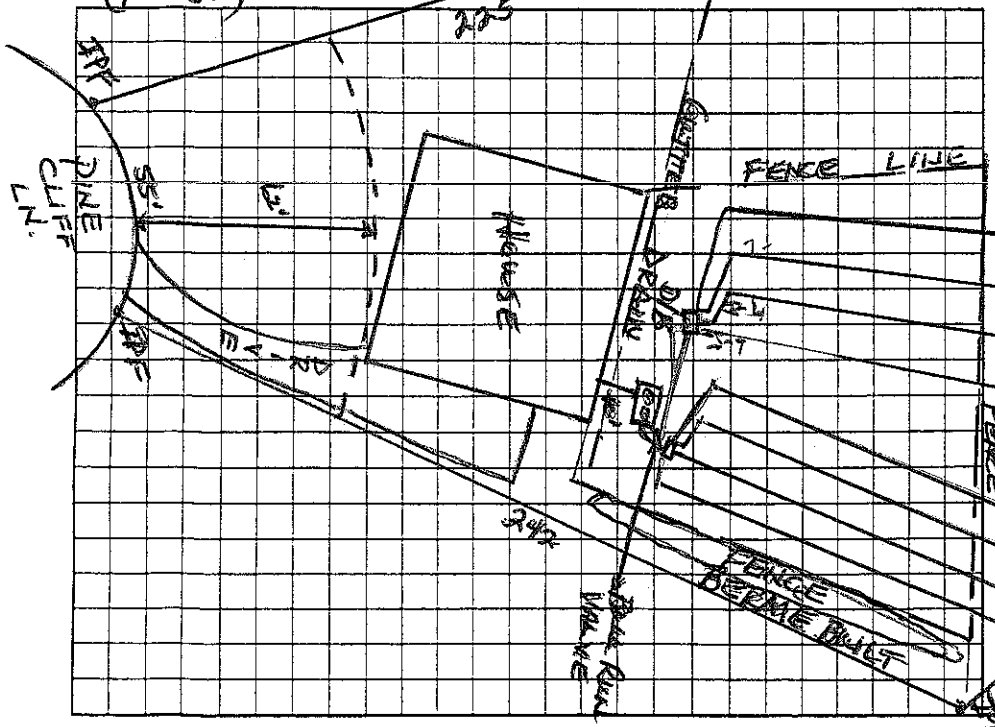

AS BUILT SKETCH

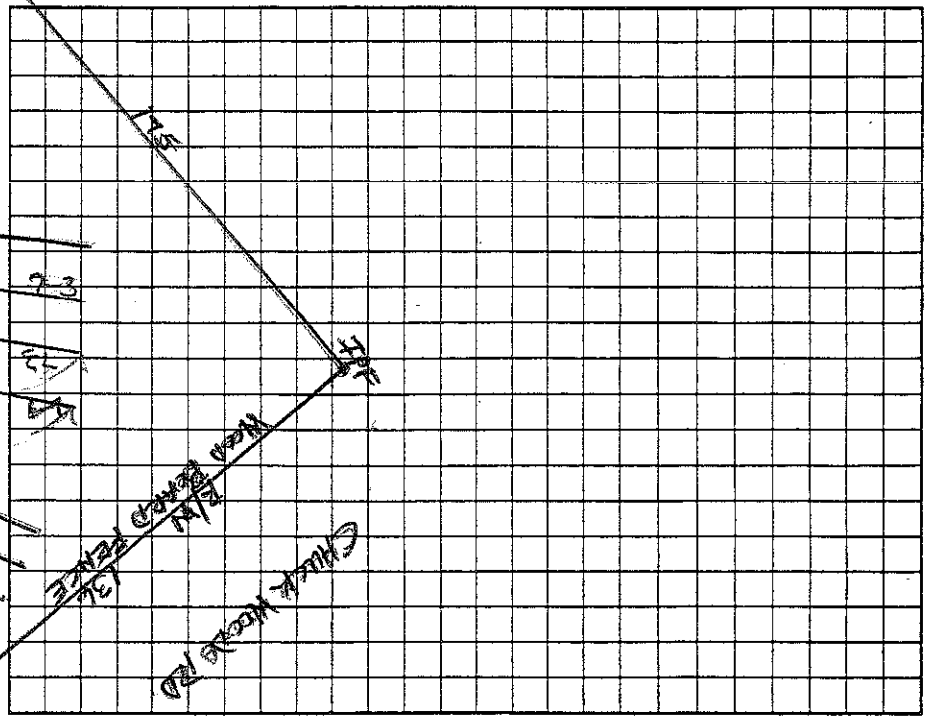

Permit can be suspended or revoked if any false information is supplied toward securing the permit/any unauthorized changes are made to the site/any unauthorized changes are made in the installation of the system. Improvement Permit with plat valid without expiration ☐ Improvement Permit with site plan valid for sixty months ☐ Authorization to Construct is valid for a period equal to that of Improvement Permit – not to exceed sixty months.

Signed: * Margaret McAlister date 2/15/07

Improvement Permit by: Wesley Sparks R.S. date 2/14/07

Authorization to Construct by: Wesley Sparks R.S. date 2/14/07

Installed by: Charles Beatty

Operation Permit by: Wesley Sparks R.S. date 6/25/07

Existing System Inspection by: date

HEALTH DEPT. COPY: WHITE OWNER COPY (FINAL): YELLOW OWNER COPY (INITIAL): PINK

IREDELL COUNTY HEALTH DEPARTMENT

S[illegible]ESVILLE 704-878-5305 MOORESVILLE 704-664-5281

IMPROVEMENT PERMIT / ~~CERTIFICATE OF COMPLETION~~ / OPERATION PERMIT / EXISTING SYSTEM INSPECTION

PROPERTY DESCRIPTION NO. 20152 DATE 6/6/96 TAX MAP NO. pt of 2CA3 Watershed: ☒ Yes ☐ No

OWNER OR CONTRACTOR Sawyer Burbank PHONE: Business ~~Home~~ 4626-51-1098

ADDRESS PO Box 176 Davidson NC 28036

LOCATION Brawley Sch TR Bay Harbour TR Pine Cliff, cul de sac directly ahead.

SUBDIVISION HARBOUR BLOCK / SECTION ~~1~~ LOT 81 LOT AREA 25000 SITE CLASS. PS DESIGN FLOW 480 L.T.A.R. .3

Septic Tank: 1000 Gallons; STB 825 Date 3/12/96

Pump Tank: _____ Gallons; PT _____ Date _____

Pump Make: _____ Model _____ Serial No. _____

Nitrification Field: No Fields 1 Square Feet 1600 Linear Feet ~~X~~ 400

No Lines 4 Trench Width 36" Max Trench Bottom Depth 36" Gravel Depth SAND.

☒ New System ☐ Repair System Type: I, II, III, IV, V, VI

System Description: Ch. Plastic - Gravity

Repair System Description: Same

Maintenance Agreement Required: ☐ Yes ☒ No

☒ House/Mod. Home No. Bedrooms 4

☐ Mobile Home No. Bathrooms 3

☐ Business No. Employees ____

☐ Other _____


☐ Slab ☒ Crawl Space ☐ Basement w/plumbing ☐ Basement wo/plumbing

Water Supply:
☐ Individual
☒ Community
☐ Public

Comments:

Comments:

INITIAL SITE SKETCH

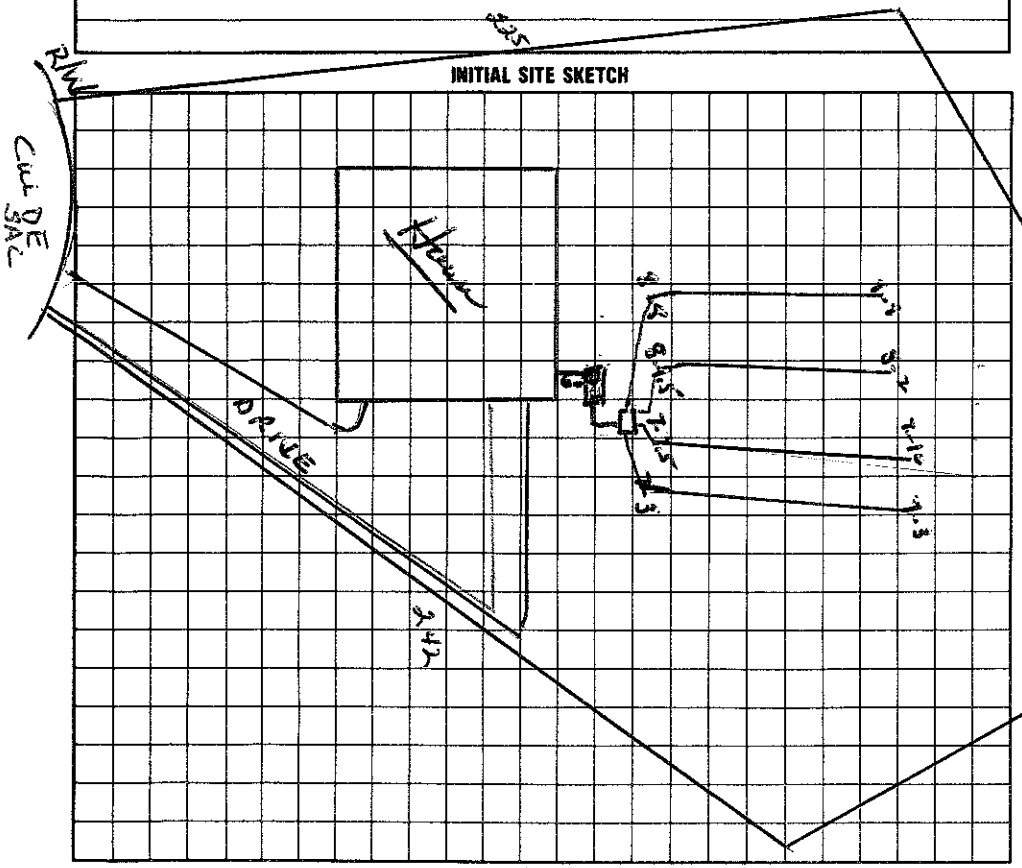

AS BUILT SKETCH

I understand that this permit can be suspended or revoked if any false information is supplied toward securing the permit/any unauthorized changes are made to the site/any unauthorized changes are made in the installation of the system.

Signed: _____ Installed by: Ben Thompson

Improvement Permit by: _____ date _____ Certificate of Completion by: _____ date _____

Existing System Inspection by: _____ date _____ Operation Permit by: Wesley Sparks RS date 6/25/96

HEALTH DEPT. COPY: WHITE INSPECTION COPY (FINAL): GREEN OWNER COPY (FINAL): YELLOW INSPECTION COPY (INITIAL): PINK OWNER COPY (INITIAL): GOLD