IREDELL COUNTY HEALTH DEPARTMENT

STATESVILLE 704-878-5305 550.00 Paid MOORESVILLE 704-664-5281 3:30-4

IMPROVEMENT PERMIT / AUTHORIZATION TO CONSTRUCT / OPERATION PERMIT / EXISTING SYSTEM INSPECTION

PERMIT# 135144 PIN# 4626511440 DATE 5-16-06

OWNER OR APPLICANT Ann Marie & John McVannon PHONE: Business 704-231-5201 Home

ADDRESS 228 Chuckwood Rd Mooresville 28117

LOCATION Brawley School Rd TR Chuckwood (228 Chuckwood)

SUBDIVISION Holiday Harbor BLOCK / SECTION LOT 78,77 LOT AREA .733Ac SITE CLASS PS DESIGN FLOW 360gpd L.T.A.R. .3 gpd/ft²

Septic Tank: 1000 Gallons; STB Existing Date

Pump Tank: 1000 Gallons; PT 318 Date 7/21/06

Pump Make: Zoeller Model N/53 Serial No.

Nitrification Field: No Fields 1 Square Feet 1200 Linear Feet 300

No Lines 6@50' Trench Width 36" Max Trench Bottom Depth 36" Gravel Depth NA ☐ Gravity ☒ Pressure

☒ New System ☐ Repair ☐ Expansion System Type: I II (III) IV V VI

System Description: 25% reduction pump pm

Repair System Description: 25% reduction pump pm

Maintenance Agreement Required: ☐ Yes ☒ No

☒ House/Mod. Home ☐ Mobile Home ☐ Business ☐ Other

No. Bedrooms 3 No. Persons No. Employees

Water Supply: ☒ Individual ☐ Public ☐ Community


☐ Slab ☒ Crawl Space ☐ Basement w/plumbing ☐ Basement wo/plumbing

Comments:/Conditions: May use existing septic tank if in good condition that meets rules
Existing system to be disconnected
Keep new trench 5' from existing


Comments:/Conditions:

1"=40'

INITIAL SITE SKETCH

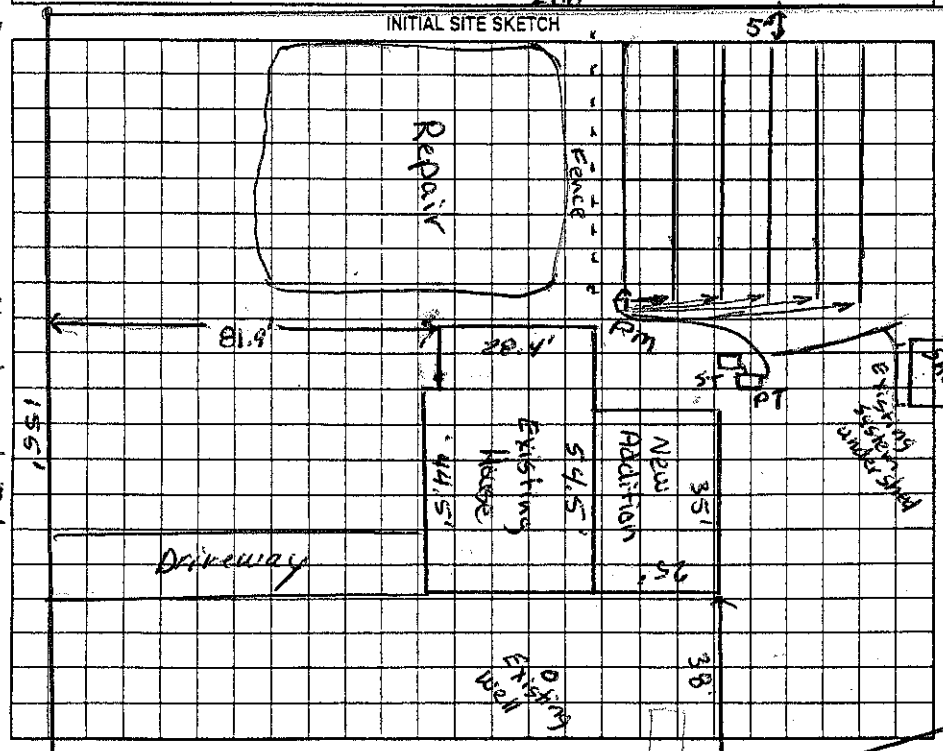

AS BUILT SKETCH

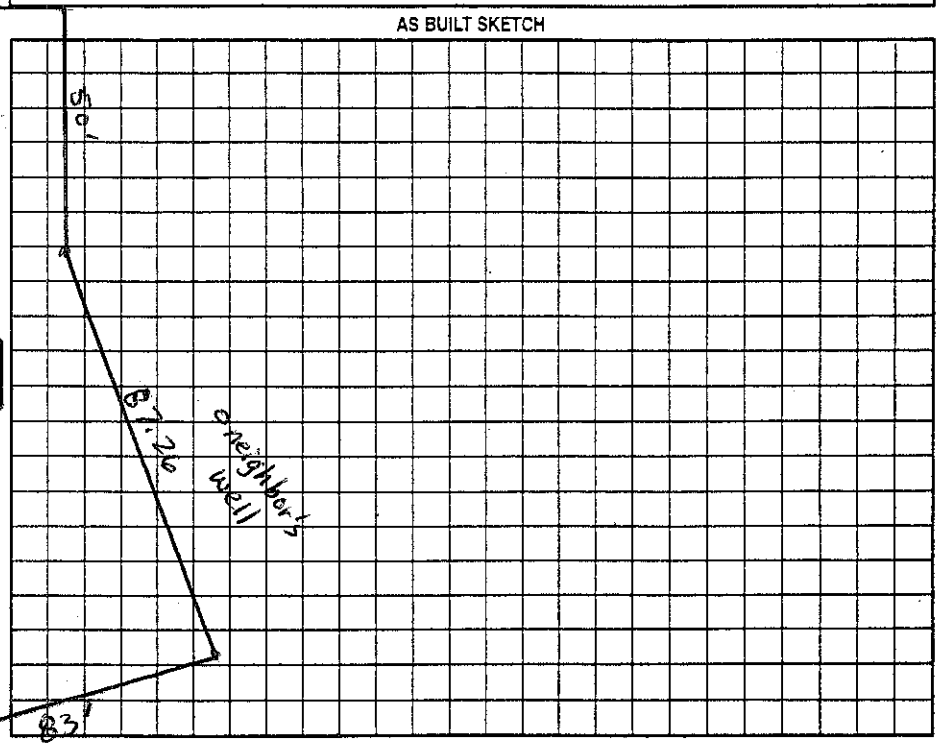

Permit can be suspended or revoked if any false information is supplied toward securing the permit/any unauthorized changes are made to the site/any unauthorized changes are made in the installation of the system. Improvement Permit with plat valid without expiration ☐ 150' Improvement Permit with site plan valid for sixty months ☒ Authorization to Construct is valid for a period equal to that of Improvement Permit – not to exceed sixty months.

Signed: Ann McVannon date 5-18-06 Installed by: Piedmont Septic

Improvement Permit by: Judy McMillian date 5-16-06 Operation Permit by: Judy McMillian date 5-9-07

Authorization to Construct by: Judy McMillian date 5-16-06 Existing System Inspection by: date

HEALTH DEPT. COPY: WHITE OWNER COPY (FINAL): YELLOW OWNER COPY (INITIAL): PINK