IREDELL COUNTY HEALTH DEPARTMENT

→ AUTHORIZATION TO CONSTRUCT

STATESVILLE 704-878-5305 MOORESVILLE 704-664-5281

IMPROVEMENT PERMIT / ~~CERTIFICATE OF COMPLETION~~ / OPERATION PERMIT / EXISTING SYSTEM INSPECTION

PROPERTY DESCRIPTION NO. 24499 DATE 8/1/96 TAX MAP NO. 2F-6-A-73 Watershed: ☑ Yes ☐ No

OWNER OR CONTRACTOR MICHAEL SHELOR ~~PHONE: Business~~ 4626-51-1589 Home 483-1073

ADDRESS 6807 DOLPHIN CT. STERRILLS FORD NC 28673

LOCATION BRAWLEY SCHOOL - TR CHUCK WOOD - TR SEA GROVE - TL LAKELAND - 2ND LOT ON LEFT

SUBDIVISION HOLIDAY HARBOR BLOCK / SECTION - LOT 73 LOT AREA .5 ac SITE CLASS PS DESIGN FLOW 360gpd L.T.A.R. .3gal/ft²

Septic Tank: 1000 Gallons; STB 794 Date 12/2/97

Pump Tank: ____ Gallons; PT ____ Date ____

Pump Make: ____ Model ____ Serial No. ____

Nitrification Field: No Fields 1 Square Feet 900 Linear Feet 300

No Lines ~~4~~ 6 Trench Width 36" Max Trench Bottom Depth 36" Gravel Depth N/A

☑ New System ☐ Repair System Type: I, II, III, IV, V, VI

System Description: GRAVITY CHAMBERED

Repair System Description: Deeded before 83

Maintenance Agreement Required: ☐ Yes ☑ No

☑ House/Mod. Home ☐ Mobile Home ☐ Business ☐ Other

No. Bedrooms 3 No. Bathrooms 2 No. Employees ____


☐ Slab ☑ Crawl Space ☐ Basement w/plumbing ☐ Basement wo/plumbing

Water Supply: ☑ Individual ☐ Community ☐ Public


Comments: WELL 40' OFF OF SIDE PROPERTY LINES. STAY OUT OF DRAINAGE WAY WITH LINES.

Comments: 3/6/98 Maycuse 5 lines 60' x 36" installed into the same area - RWS

INITIAL SITE SKETCH

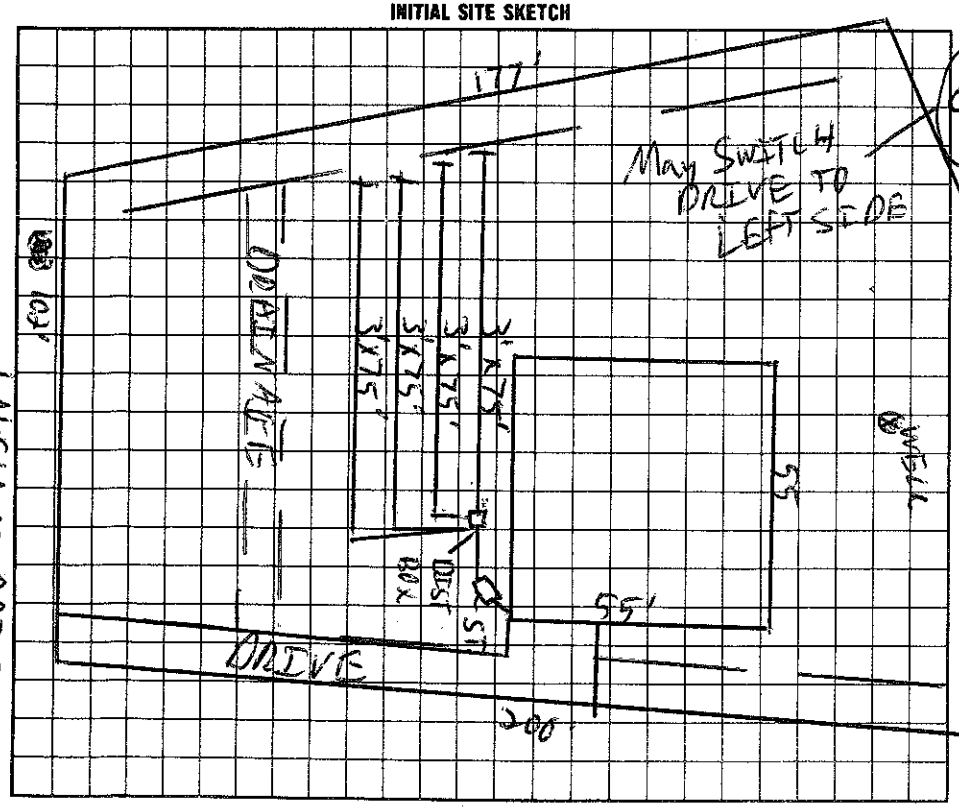

AS BUILT SKETCH

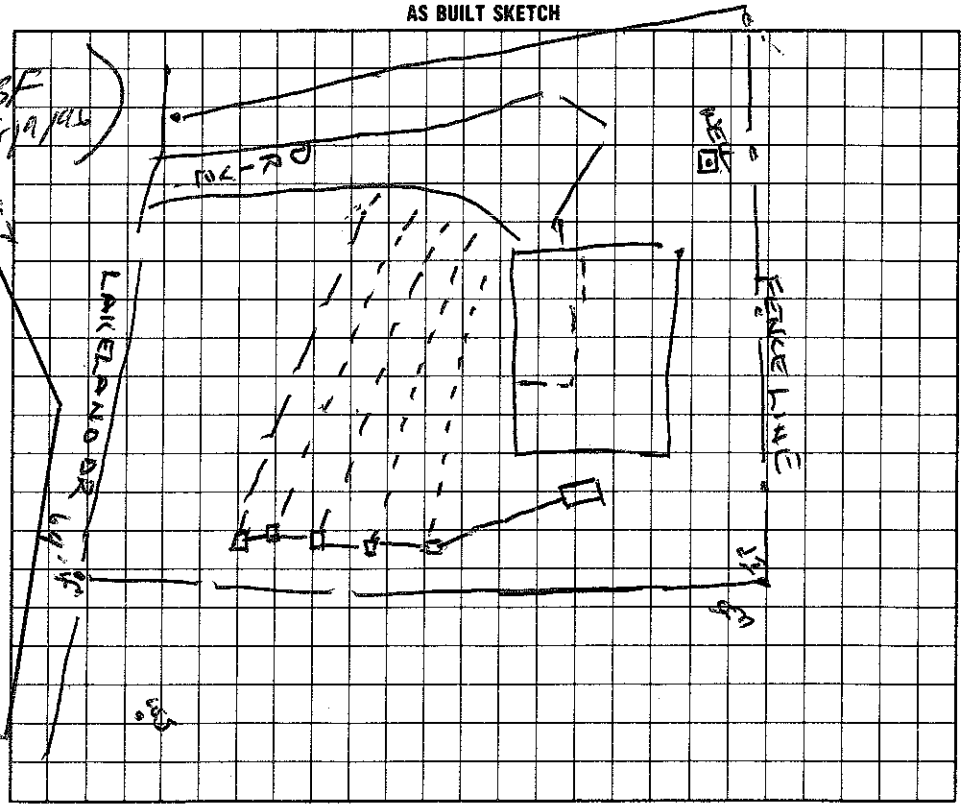

I understand that this permit can be suspended or revoked if any false information is supplied toward securing the permit/any unauthorized changes are made to the site/any unauthorized changes are made in the installation of the system.

Signed: Jeana Young

Improvement Permit by: C. Bobby Thomas EHSE date 8/1/96

CONSTRUCTION AUTHORIZATION Existing System Inspection by: C. Bobby Thomas EHSE date 8/1/96

Installed by: Chaney Septic Service

Certificate of Completion by: Wesley Sparks RS. date 4/1/98

Operation Permit by: Wesley Sparks RS date 4/1/98

HEALTH DEPT. COPY: WHITE INSPECTION COPY (FINAL): GREEN OWNER COPY (FINAL): YELLOW INSPECTION COPY (INITIAL): PINK OWNER COPY (INITIAL): GOLD

AUTHORIZATION TO CONSTRUCT IS VALID FOR 60 MONTHS FROM ISSUE DATE