IREDELL COUNTY HEALTH DEPARTMENT

STATESVILLE 704-878-5305 MOORESVILLE 704-664-5281

IMPROVEMENT PERMIT / CERTIFICATE OF COMPLETION / OPERATION PERMIT / EXISTING SYSTEM INSPECTIO

PROPERTY DESCRIPTION NO. 22727 DATE Dec. 29, 95 TAX MAP NO. 2F-6-A-75 Watershed: ☑ Yes ☐ No

OWNER OR CONTRACTOR Charles L. Smith ~~PHONE: Business~~ 4626-51-3436 Home UB4CA

ADDRESS 431 E. Center Mooresville N.C. 28115

LOCATION Brawley Sch. Rd. TR Chuckwood TR Seagrove Ln. ~200' on left

SUBDIVISION Holiday Harbor BLOCK / SECTION ____ LOT 75 LOT AREA 25,168 ft² SITE CLASS. Spec. 1956 DESIGN FLOW 360 gpd L.T.A.R. .3

Septic Tank: 1000 Gallons; STB 825 Date 5/11/96

Pump Tank: ____ Gallons; PT ____ Date ____

Pump Make: ____ Model ____ Serial No. ____

Nitrification Field: No Fields 1 Square Feet 900 Linear Feet 300

No Lines 4@ 75' Trench Width 36" Max Trench Bottom Depth ~24" Gravel Depth N/A

☑ New System ☐ Repair System Type: I, II, III, IV, V, VI

System Description: gravity Infiltrator

Repair System Description: Same

Maintenance Agreement Required: ☐ Yes ☑ No

☑ House/Mod. Home No. Bedrooms 3

☐ Mobile Home No. Bathrooms 2

☐ Business No. Employees ____

☐ Other ____

☐ Slab ☑ Crawl Space ☐ Basement w/plumbing ☐ Basement wo/plumbing


Water Supply: ☑ Individual ☐ Community ☐ Public

Comments: Lot recorded prior to 1977. Stormwater diversion needed to direct water down left side line and then to rear line.


Comments: Lines, Tanks checked on 6/12/96

1" = 50'

INITIAL SITE SKETCH

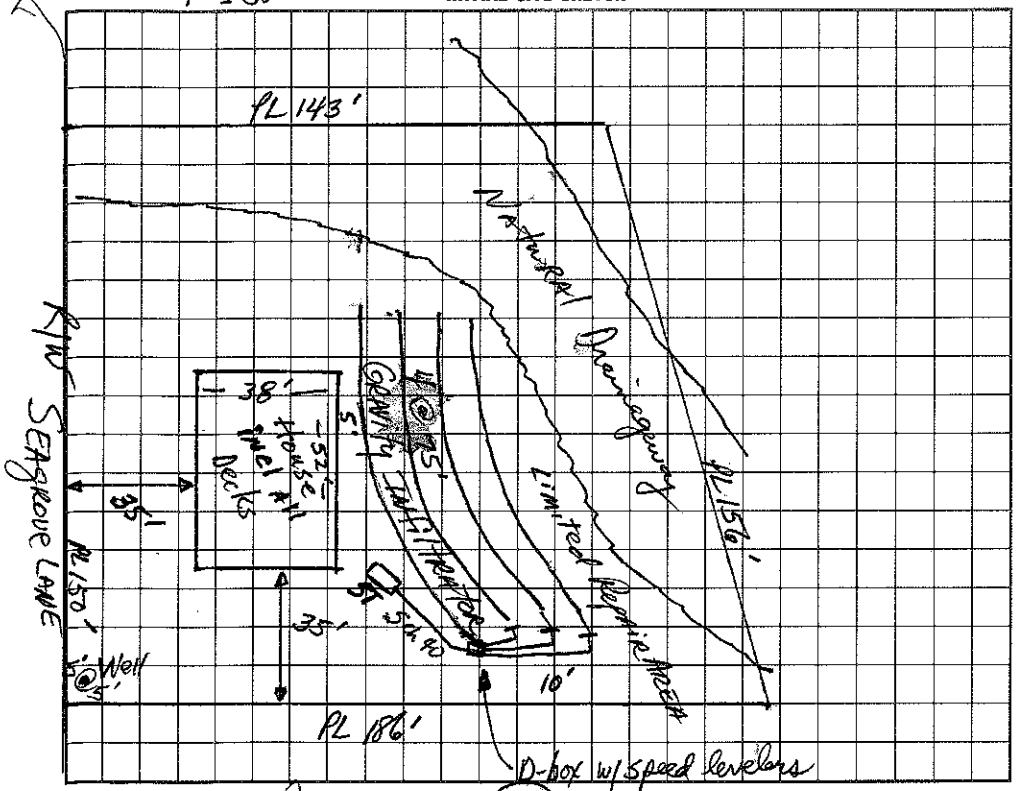

AS BUILT SKETCH

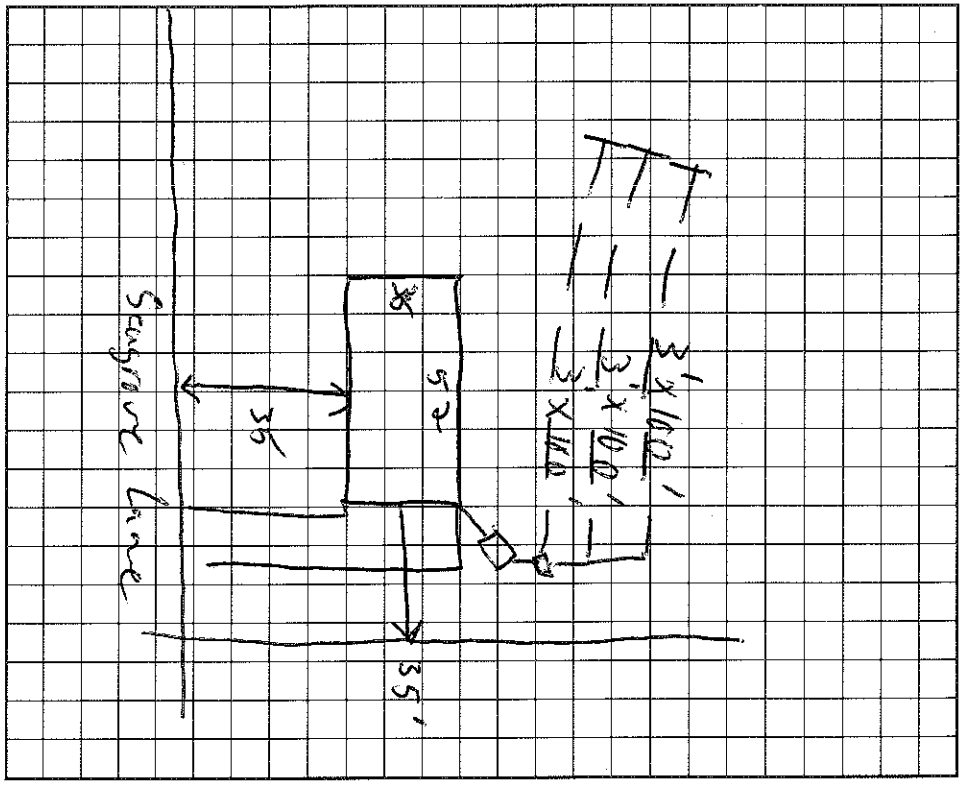

I understand that this permit can be suspended or revoked if any false information is supplied toward securing the permit/any unauthorized changes are made to the site/any unauthorized changes are made in the installation of the system.

Signed: Charles L. Smith

Improvement Permit by: [signature] RS date 12-29-95

~~Existing System Inspection by:~~ [signature] RS date 12-29-95

Installed by: Thompson's Earthworks

Certificate of Completion by: ____ date ____

Operation Permit by: C. Kirby Hall EHSI date 6/13/96

Authorize 1 additional

HEALTH DEPT. COPY: WHITE INSPECTION COPY (FINAL): GREEN OWNER COPY (FINAL): YELLOW INSPECTION COPY (INITIAL): PINK OWNER COPY (INITIAL): GOLD