IREDELL COUNTY HEALTH DEPARTMENT

Authorization to Construct

STATESVILLE 704-878-5305 MOORESVILLE 704-664-5281

IMPROVEMENT PERMIT / ~~CERTIFICATE OF COMPLETION~~ / OPERATION PERMIT / EXISTING SYSTEM INSPECTION

PROPERTY DESCRIPTION NO. 23061 DATE 2/26/96 TAX MAP NO. 2F 6M 17 Watershed: [X] Yes [ ] No

OWNER OR CONTRACTOR Waldo Builders Inc. PHONE: Business 662-9468 ~~Home~~ 4626-51-5827

ADDRESS 201 N Church St. Mooresville, NC 28115

LOCATION Seagrove Rd. - Brawley Sch Rd. TR Chuckwood TR Seagrove to first lot on (E) before culdesac

SUBDIVISION Holiday Harbor BLOCK / SECTION ____ LOT 17 LOT AREA < 20,000 Ft² SITE CLASS. PS DESIGN FLOW 360 L.T.A.R. .35

Septic Tank: 1000 Gallons; STB 794 Date 5-24-96

Pump Tank: ____ Gallons; PT ____ Date ____

Pump Make: ____ Model ____ Serial No. ____

Nitrification Field: No Fields 1 Square Feet 1028 Linear Feet (342) *180

No Lines 4 Trench Width 24" Max Trench Bottom Depth 36" Gravel Depth 10" SAND

[X] New System [ ] Repair System Type: I. II. (III) IV. V. VI

System Description: 16" PPBS - DIST BOX

Repair System Description: SAME

Maintenance Agreement Required: [ ] Yes [X] No

[X] House/Mod. Home No. Bedrooms 3

[ ] Mobile Home No. Bathrooms 2

[ ] Business No. Employees ____

[ ] Other ____


[ ] Slab [X] Crawl Space [ ] Basement w/plumbing [ ] Basement wo/plumbing

Water Supply: [X] Individual [ ] Community [ ] Public

Comments:

Comments:

INITIAL SITE SKETCH 1" = 40'

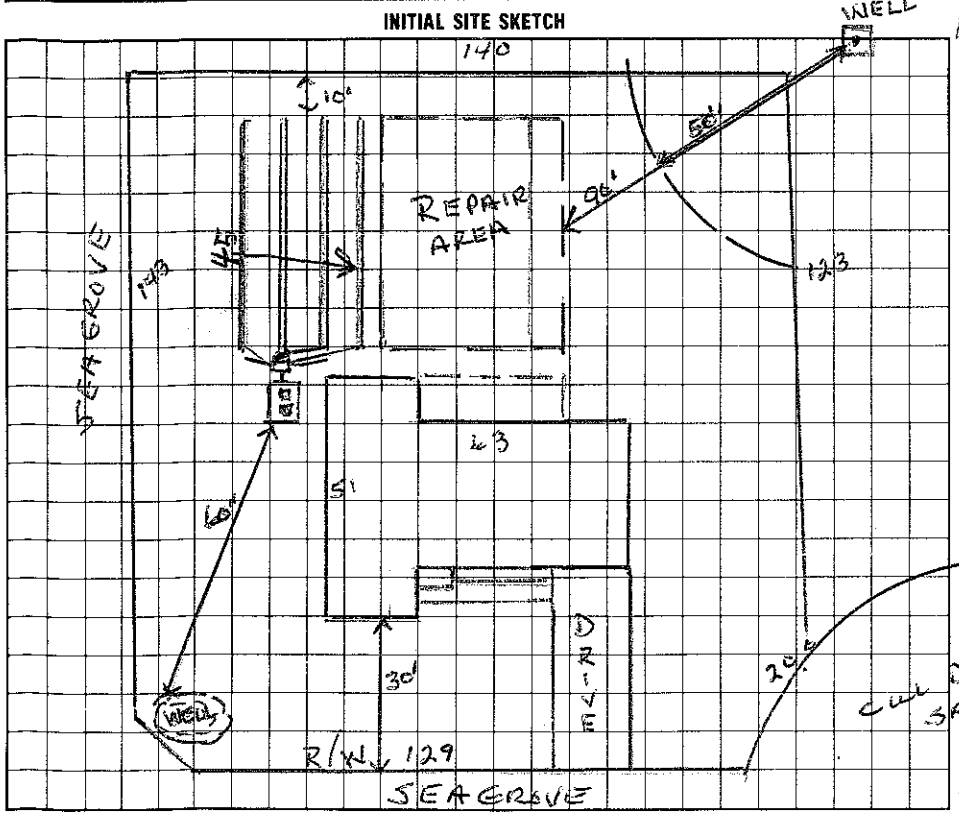

AS BUILT SKETCH

Same as side sketch

I understand that this permit can be suspended or revoked if any false information is supplied toward securing the permit/any unauthorized changes are made to the site/any unauthorized changes are made in the installation of the system.

Auth to Construct valid 5 years.

Signed: ____

Improvement Permit by: Wesley Sparks R.S. date 2/27/96

Auth to Construct Existing System Inspection by: Wesley Sparks R.S. date 2/27/96

Installed by: Waldo Builders

Certificate of Completion by: ____ date ____

Operation Permit by: C. Beverly Thomas EHSI date 7/24/96

HEALTH DEPT. COPY: WHITE INSPECTION COPY (FINAL): GREEN OWNER COPY (FINAL): YELLOW INSPECTION COPY (INITIAL): PINK OWNER COPY (INITIAL): GOLD