IREDELL COUNTY HEALTH DEPARTMENT

STATE E 704-878-5305 50.00 Paid MOORESVILLE 704-664-5281

IMPROVEMENT PERMIT / AUTHORIZATION TO CONSTRUCT / PERATION PERMIT / EXISTING SYSTEM INSPECTION

PERMIT# 12578 PIN# ~~4626-63-7315~~ 4626518464 DATE 11/5/04

OWNER OR CONTRACTOR The Hoke Company Inc. PHONE: Business 704-799-9495 Home

ADDRESS PO Box 4448 Mooresville NC 28117

LOCATION BSR, TR South Fork, TL Freshwater, on Lt near End

SUBDIVISION Farms BLOCK / SECTION 2 LOT 248 LOT AREA 1.35Ac SITE CLASS. PS DESIGN FLOW 600 L.T.A.R. 0.3

Septic Tank: 1500 Gallons; STB 338 Date 10-23-04
Pump Tank: 1500 Gallons; PT 477 Date 12-5-04
Pump Make: Gould's Model WE0312M Serial No.
Nitrification Field: No Fields 1 Square Feet 1500 Linear Feet 500
No Lines 4@125' Trench Width 36" Max Trench Bottom Depth 36" Gravel Depth —

☒ New System ☐ Repair System Type: I, II, (III), IV, V, VI
System Description: Press. Man. 25% Reduct.
Repair System Description: Same
Maintenance Agreement Required: ☐ Yes ☒ No

☒ House/Mod. Home No. Bedrooms 5
☐ Mobile Home No. Bathrooms
☐ Business No. Employees
☐ Other

☐ Slab ☒ Crawl Space ☐ Basement w/plumbing ☐ Basement wo/plumbing


Water Supply: ☐ Individual ☐ Public ☒ Community

Comments/Conditions: @ 5@100'


1"=50'

Comments/Conditions: 11/7/05 EZ Flow installed as Drainfield

INITIAL SITE SKETCH

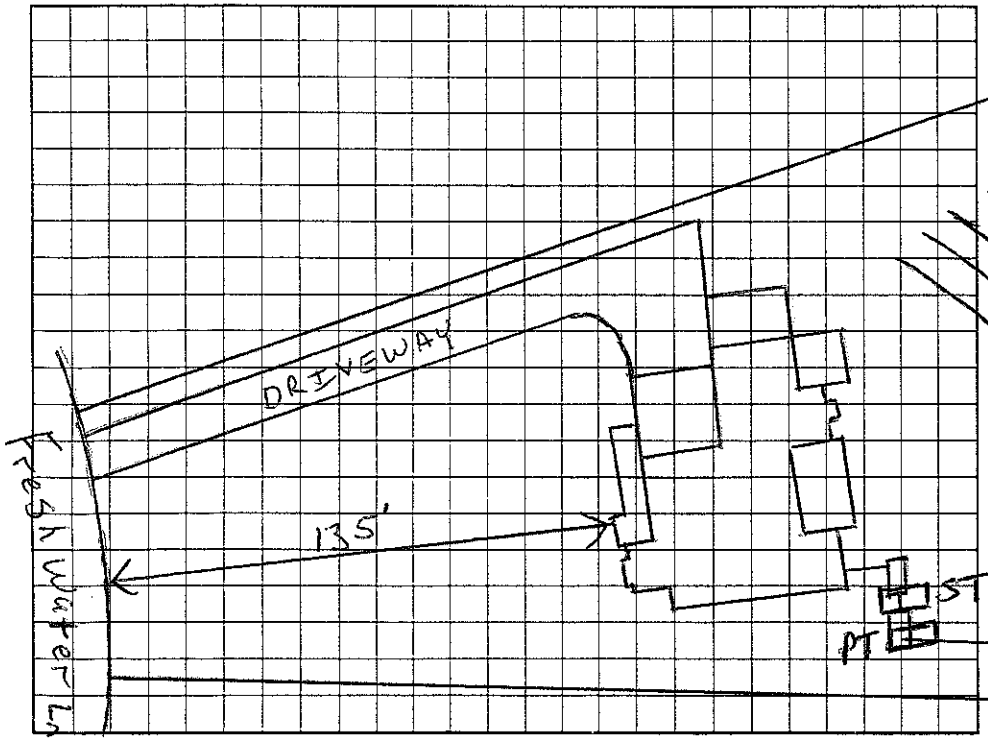

AS BUILT SKETCH

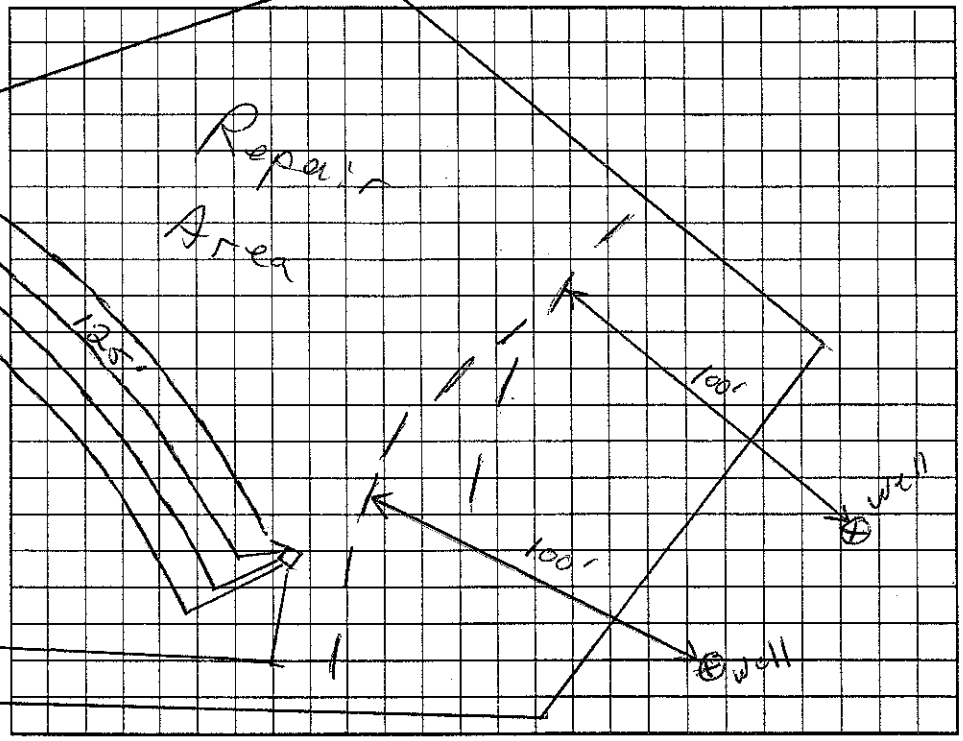

Permit can be suspended or revoked if any false information is supplied toward securing the permit/any unauthorized changes are made to the site/any unauthorized changes are made in the installation of the system. Improvement Permit with plat valid without expiration. Improvement Permit with site plan valid for sixty months. Authorization to Construct is valid for a period equal to that of Improvement Permit -- not to exceed sixty months.

Signed: [signature] date 1-7-05 Installed by: R&H

Improvement Permit by: [signature] RS date 11/5/04 Operation Permit by: [signature] RS date 5/5/05

Authorization to Construct by: [signature] RS date 11/5/04 Existing System Inspection by: date

HEALTH DEPT. COPY: WHITE OWNER COPY (FINAL): YELLOW OWNER COPY (INITIAL): PINK