IREDELL COUNTY HEALTH DEPARTMENT

STATESVILLE 878-5305 MOORESVILLE 704-664-5281

IMPROVEMENT PERMIT / AUTHORIZATION TO CONSTRUCT / OPERATION PERMIT / EXISTING SYSTEM INSPECTION

PERMIT# 112576 PIN# 4626637315.246 4626518784 DATE 7/31/03

OWNER OR CONTRACTOR CRESCENT RESOURCES / ES Johnson PHONE: Business 660-1185 Home

ADDRESS 2214 BRAWLEY SCHOOL - Mooresville NC 28117

LOCATION BRAWLEY SCHOOL - JR SOUTHFORK - JL FRESHWATER - AT END

SUBDIVISION THE FARMS BLOCK / SECTION 2 LOT 246 LOT AREA .77AC SITE CLASS. RS DESIGN FLOW 450GPD L.T.A.R. .36PD/FT

Septic Tank: 1000 Gallons; STB 338 Date 9-19-04

Pump Tank: Gallons; PT Date

Pump Make: Model Serial No.

Nitrification Field: No Fields 1 Square Feet 1200 Linear Feet 400

No Lines 5@80' Trench Width 36" Max Trench Bottom Depth 36" Gravel Depth N/A

☑ New System ☐ Repair System Type: I, II, III, IV, V, VI

System Description: GRAVITY 25% REDUCTION

Repair System Description: PUMP SAME

Maintenance Agreement Required: ☐ Yes ☑ No

☑ House/Mod. Home ☐ Mobile Home ☐ Business ☐ Other

No. Bedrooms 4 No. Bathrooms 4 No. Employees


☐ Slab ☑ Crawl Space ☐ Basement w/plumbing ☐ Basement wo/plumbing

Water Supply: ☐ Individual ☐ Public ☑ ~~Community~~


Comments:/Conditions:

Comments:/Conditions: Checked tank & lines Installed As Drawn Used EZ Flow

1"=50' INITIAL SITE SKETCH

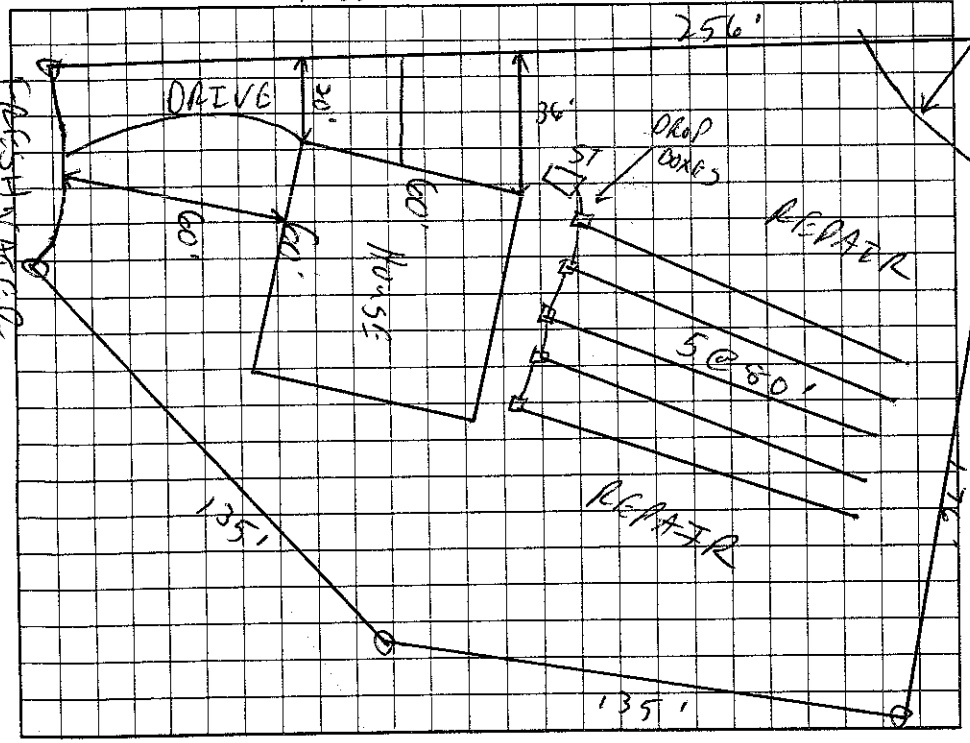

AS BUILT SKETCH

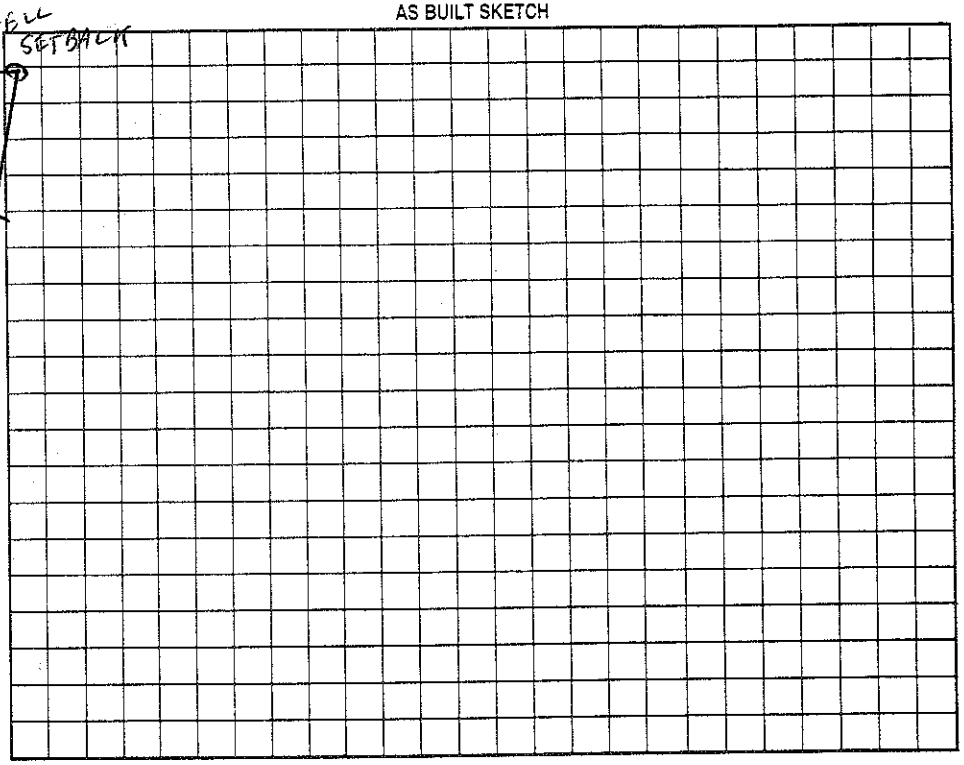

Permit can be suspended or revoked if any false information is supplied toward securing the permit/any unauthorized changes are made to the site/any unauthorized changes are made in the installation of the system. Improvement Permit with plat valid without expiration. Improvement Permit with site plan valid for sixty months. Authorization to Construct is valid for a period equal to that of Improvement Permit – not to exceed sixty months.

Signed: date 8-25-03

Improvement Permit by: RS date 7/31/03

Authorization to Construct by: RS date 5/25/04

Installed by: Willie Christenbury

Operation Permit by: RS date 10/25/04

Existing System Inspection by: date

HEALTH DEPT. COPY: WHITE OWNER COPY (FINAL): YELLOW OWNER COPY (INITIAL): PINK