IREDELL COUNTY HEALTH DEPARTMENT

STATESVILLE 704-878-5305 MOORESVILLE 704-664-5281

IMPROVEMENT PERMIT / AUTHORIZATION TO CONSTRUCT / OPERATION PERMIT / EXISTING SYSTEM INSPECTION

PERMIT# 112574 PIN# ~~4686637315.245~~ 4626519934 DATE 9/14/03

OWNER OR CONTRACTOR CRESCENT RESOURCES / HHZ PHONE: Business 660-1185 Home

ADDRESS 2214 BEAVER SCHOOL MOORESVILLE 28117

LOCATION BEAVER SCHOOL - TR SOUTH FORK - TL FRESHWATER FT END #229

SUBDIVISION THE FARMS BLOCK / SECTION 2 LOT 245 LOT AREA ~2.9 AC SITE CLASS. AS DESIGN FLOW 480GPD L.T.A.R. .360 / KFA

Septic Tank: 1000 Gallons; STB 338 Date 4-19-05

Pump Tank: 1000 Gallons; PT 283 Date 4-1-05

Pump Make: Model Serial No.

Nitrification Field: No Fields 1 Square Feet 1200 Linear Feet 400

No Lines 5 @ 80' Trench Width 36" Max Trench Bottom Depth 36" Gravel Depth N/A

☑ New System ☐ Repair System Type: I, II, III, IV, V, VI

System Description: PUMP 25% REDUCTION

Repair System Description: SAME

Maintenance Agreement Required: ☐ Yes ☐ No

☑ House/Mod. Home No. Bedrooms 4

☐ Mobile Home No. Bathrooms 4

☐ Business No. Employees

☐ Other


☐ Slab ☑ Crawl Space ☑ Basement w/plumbing ☐ Basement wo/plumbing

Water Supply: ☐ Individual ☐ Public ☑ Community


Comments:/Conditions: Reviewed plans, essentially in compliance with original permit.

Comments:/Conditions: PARTIAL ~~LA~~ Note: House being moved up however there should still be enough room for 25% Reduction System.

1" = 50' INITIAL SITE SKETCH

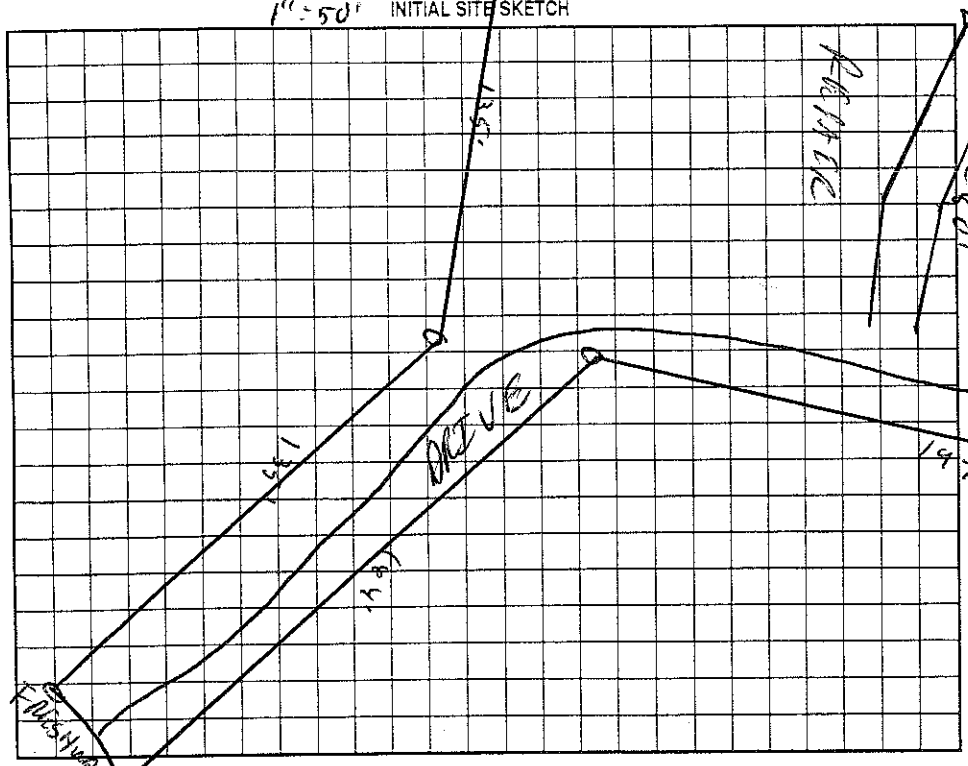

AS BUILT SKETCH

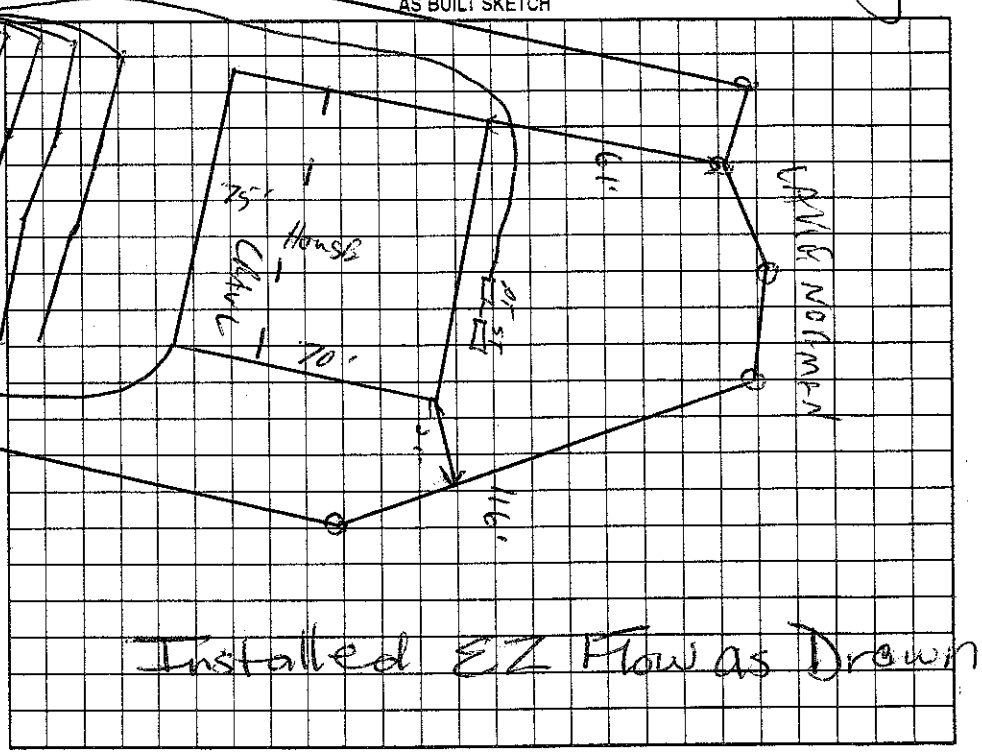

Permit can be suspended or revoked if any false information is supplied toward securing the permit/any unauthorized changes are made to the site/any unauthorized changes are made in the installation of the system. Improvement Permit with plat valid without expiration. Improvement Permit with site plan valid for sixty months. Authorization to Construct is valid for a period equal to that of Improvement Permit – not to exceed sixty months.

Signed: date 9-25-03 Installed by: Bobby Mayhew RS

Improvement Permit by: date 9/19/03 Operation Permit by: date 8/16/05

Authorization to Construct by: date 1/12/05 Existing System Inspection by: date

HEALTH DEPT. COPY: WHITE OWNER COPY (FINAL): YELLOW OWNER COPY (INITIAL): PINK