IREDELL COUNTY HEALTH DEPARTMENT

Statesville Office (704) 878-5305 | Mooresville Office (704) 660-3625 | PERMIT # 214368

IMPROVEMENT PERMIT / AUTHORIZATION TO CONSTRUCT / OPERATION PERMIT / EXISTING SYSTEM

PIN # 4626-52-0317.000

APPLICANT: Glenn Wise (Carolina Contracting) APPLICANT ADDRESS: 935 Thorn Ridge Ln. Lake Wylie, SC 29710

SITE ADDRESS: 148 Lakeland Rd. Mooresville NC PHONE: 704-301-1072 ALT. PHONE:

SITE DIRECTIONS: BSR, TR Chuckwood, TR Seagrave, TL Lakeland, Site on R

SUBDIVISION: Holiday Harbor SECTION: LOT # 27 LOT AREA: DESIGN FLOW: Ex. 360 GPD T.A.R.: Existing

Septic Tank Ex. 1500 (gal) STB Date
Pump Tank (gal) PT Date
Pump Make Model Serial #
Nitrification Fields Ex # Lines Ex Linear Ft: Ex
Trench Width Ex Max. Trench Bottom Depth Ex Gravel Depth Ex


☐ New System ☐ Repair ☐ Expansion System Type: (II) III IV V VI
System Description: Existing Conventional - Gravity
Repair System Description: Repair Exempt
Maintenance Agreement Required: ☐ YES ☒ NO
☒ GRAVITY ☐ PRESSURE

☒ Residence No. Bedrooms Ex 3
☐ Business No. Persons Ex 6
☐ Other No. Employees
☒ Slab ☐ Crawl Space
☒ Basement w/plumbing ☐ Basement w/o plumbing


Water Supply: ☒ Private ☐ Public ☐ Community

Comments / Conditions: Maintain 25' from well with proposed structure. System flagged to be functioning @ time of inspection

INITIAL SITE SKETCH

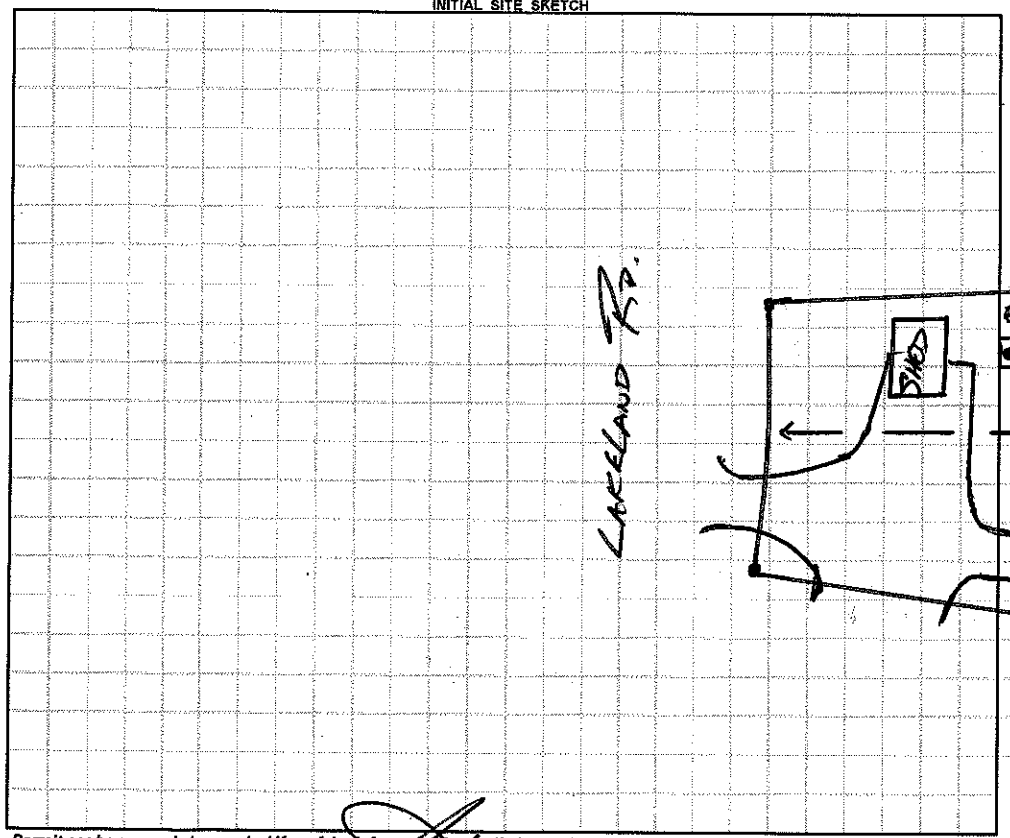

AS BUILT SKETCH

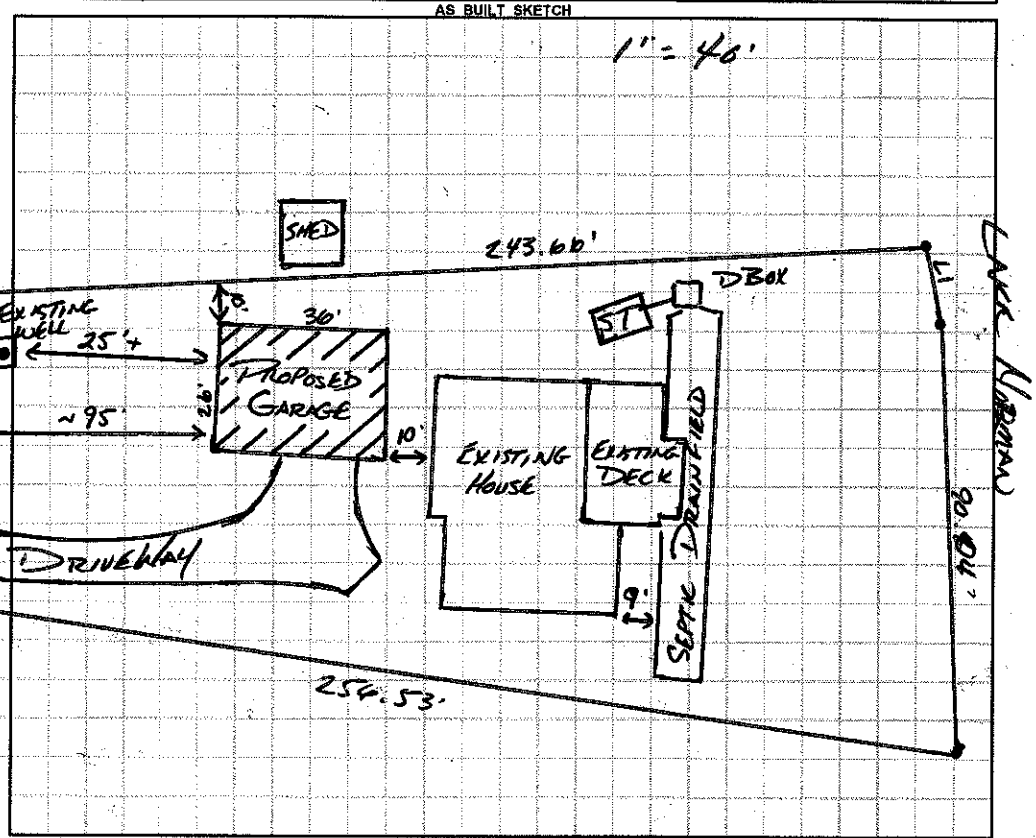

Permit can be suspended or revoked if any false information is supplied toward securing the permit / any unauthorized changes are made to the site / any unauthorized changes are made in the installation of the system. **CONTACT A LOCATOR SERVICE PRIOR TO ANY EXCAVATION**

☐ **IMPROVEMENT PERMIT** *with plat valid without expiration.* ☐ **IMPROVEMENT PERMIT** *with site plan valid for 60 mos.* ☐ **AUTHORIZATION TO CONSTRUCT** *valid for period equal to IMPROVEMENT PERMIT--not to exceed 60 mo.*

Owner / Applicant Signature: Date: 11/10/15 Installed by:

IMPROVEMENT PERMIT by: Date: OPERATION PERMIT by: Date:

AUTHORIZATION TO CONSTRUCT by: Date: Existing System Inspected by: APPROVED NOV 10 2015

Health Dept. Copy - WHITE Applicant (Final Approval) - YELLOW Applicant (Conditional Approval) - PINK