IREDELL COUNTY HEALTH DEPARTMENT

STATESVILLE 704-878-5305 MOORESVILLE 704-664-5281

IMPROVEMENT PERMIT / AUTHORIZATION TO CONSTRUCT / OPERATION PERMIT / EXISTING SYSTEM INSPECTION

PERMIT# 132281 PIN# 4626 52 1126 DATE 8/10/06

OWNER OR APPLICANT Dominic Homes Inc. PHONE: Business 704-489-9497 Home

ADDRESS PO Box 367 Catawba, NC 28682

LOCATION 1100 TR Churchwood TR Riviera TR Lakeland Lot on (L)

SUBDIVISION Holiday Heights BLOCK / SECTION LOT 24 LOT AREA .473 SITE CLASS. PS DESIGN FLOW 360 L.T.A.R. .3

Septic Tank: 1000 Gallons: STB 1012 Date 1-3-06

Pump Tank: 1000 Gallons: PT 17 Date 5-13-06

Pump Make: Goulds Model WE10T7H Serial No. 5060393 07

Nitrification Field: No Fields 1 Square Feet 600 Linear Feet 200

No Lines 5@40' Trench Width 3' Max Trench Bottom Depth 3'

[X] New System [ ] Repair [ ] Expansion System Type: I II III (IV) V VI

System Description: LPP - 1½" PPBPS

Repair System Description: < 1993 PLATTED LOT

Maintenance Agreement Required: [X] Yes [ ] No

[X] House/Mod. Home No. Bedrooms 3

[ ] Mobile Home No. Persons

[ ] Business No. Employees

[ ] Other


Water Supply: [X] Individual [ ] Public [ ] Community

Gravel Depth NA [ ] Gravity [X] Pressure [ ] Slab [X] Crawl Space [ ] Basement w/plumbing [ ] Basement wo/plumbing


Comments/Conditions: Permit changed to save TREES.
SYM TECH FILTER REQUIRED - 2' Pressure
Head. ~49' TDH 28 GAL/MIN MINIMUM
3/16" HOLES, 1 PER PANEL

Comments/Conditions: Property Lines Pin.

INITIAL SITE SKETCH

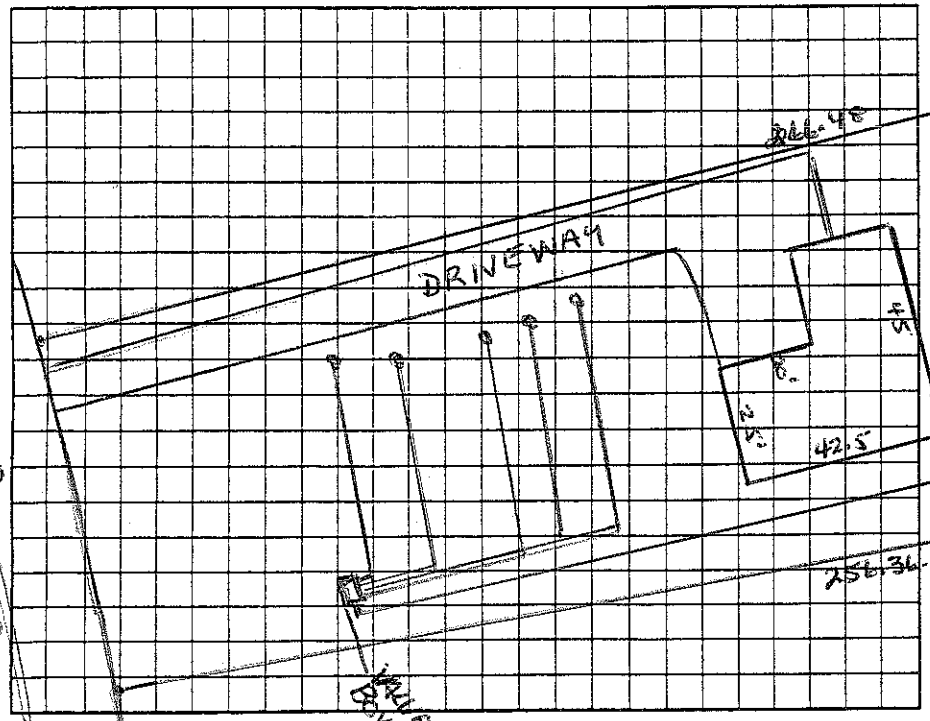

AS BUILT SKETCH

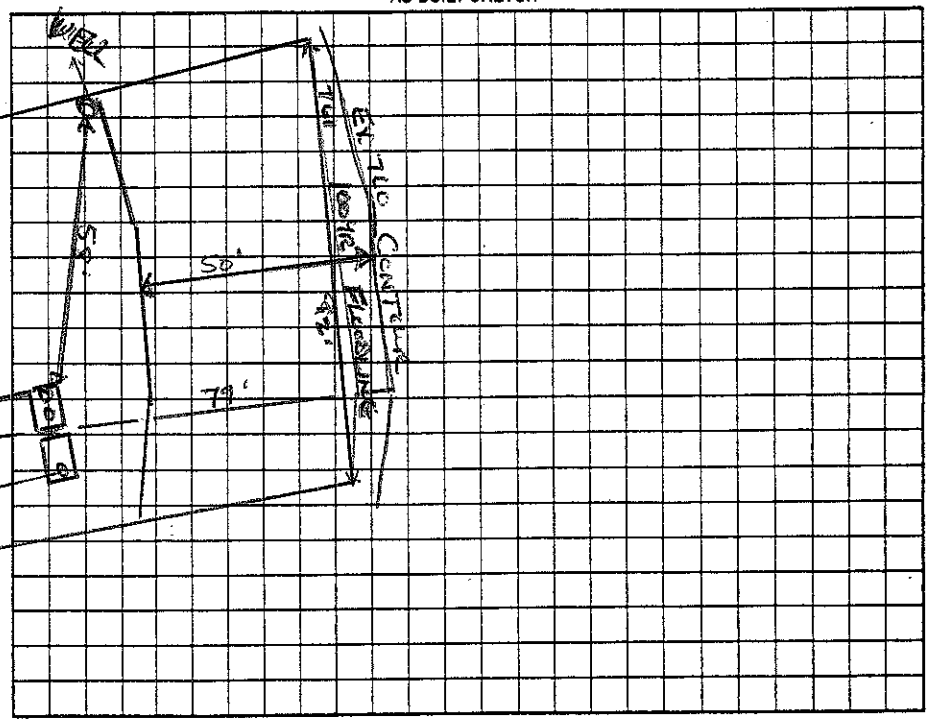

Permit can be suspended or revoked if any false information is supplied toward securing the permit/any unauthorized changes are made to the site/any unauthorized changes are made in the installation of the system. Improvement Permit with plat valid without expiration ☐ Improvement Permit with site plan valid for sixty months ☐ Authorization to Construct is valid for a period equal to that of Improvement Permit – not to exceed sixty months.

Signed: [signature] date 8/15/06

Improvement Permit by: Wesley Sparks R.S. date 8/10/06

Authorization to Construct by: Wesley Sparks R.S. date 8/10/06

Installed by: Tommy Frye

Operation Permit by: Wesley Sparks R.S. date 8/25/06

Existing System Inspection by: date

HEALTH DEPT. COPY: WHITE OWNER COPY (FINAL): YELLOW OWNER COPY (INITIAL): PINK