IREDELL COUNTY HEALTH DEPARTMENT

Statesville Phone TR 3-7271 Mooresville Phone NO 3-1271

PERMIT TO INSTALL SEPTIC TANK

Permit No. _____ Permit Date 5 July 19[illegible]

Owner Mr. Vinson Address Chas.

Installed By " Address "


Location of Property Lot 12 Sect 8

Tank		Capacity		Length of Lines		Fixtures	
Block	(✓)	1000	(✓)	225'	( )	No. of Baths	( )
Precast	( )	1250	( )	250'	( )	Dishwasher	( )
		1500	( )	Other 350' T		Garbage Grdr.	( )
		Other _____				Other _____	

NOTIFY HEALTH DEPARTMENT AT LEAST EIGHT HOURS BEFORE TANK IS TO BE INSPECTED.

Final Inspection 5 July 19__ Approved (✓) Disapproved ( )

Remarks _____

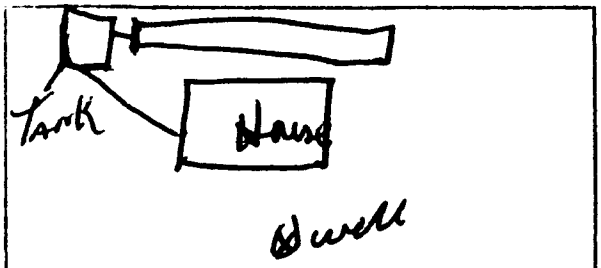

Sketch of Installation

Ray R. Georgeson RS

Sanitarian