IREDELL COUNTY HEALTH DEPARTMENT

Statesville Office (704) 878-5305 Mooresville Office (704) 660-3625 PERMIT # 222346

IMPROVEMENT PERMIT / AUTHORIZATION TO CONSTRUCT / OPERATION PERMIT / EXISTING SYSTEM

PIN # 4626-52-3195

APPLICANT: Doug Manti APPLICANT ADDRESS: 153 Seagrove Ln. - Mooresville

SITE ADDRESS: Same PHONE: ALT. PHONE:

SITE DIRECTIONS: BSR, TR Chuckwood, TR Seagrove, TL, on R

SUBDIVISION: Holiday Harbor SECTION: 1 LOT # 14 LOT AREA: DESIGN FLOW: 360 L.T.A.R.:

Septic Tank 1000 (gal) STB 2671 Date
Pump Tank (gal) PT Date
Pump Make Model Serial #
Nitrification Fields # Lines Linear Ft:
Trench Width Max. Trench Bottom Depth Gravel Depth


☐ New System ☑ Repair ☐ Expansion System Type: I II (III) IV V VI
System Description:
Repair System Description: TANK
Maintenance Agreement Required: ☐ YES ☑ NO
☑ GRAVITY ☐ PRESSURE

☑ Residence No. Bedrooms 3
☐ Business No. Persons 6
☐ Other No. Employees
☐ Slab ☐ Crawl Space
☑ Basement w/plumbing ☐ Basement w/o plumbing


Water Supply: ☒ Private ☐ Public ☐ Community

Comments / Conditions:

INITIAL SITE SKETCH

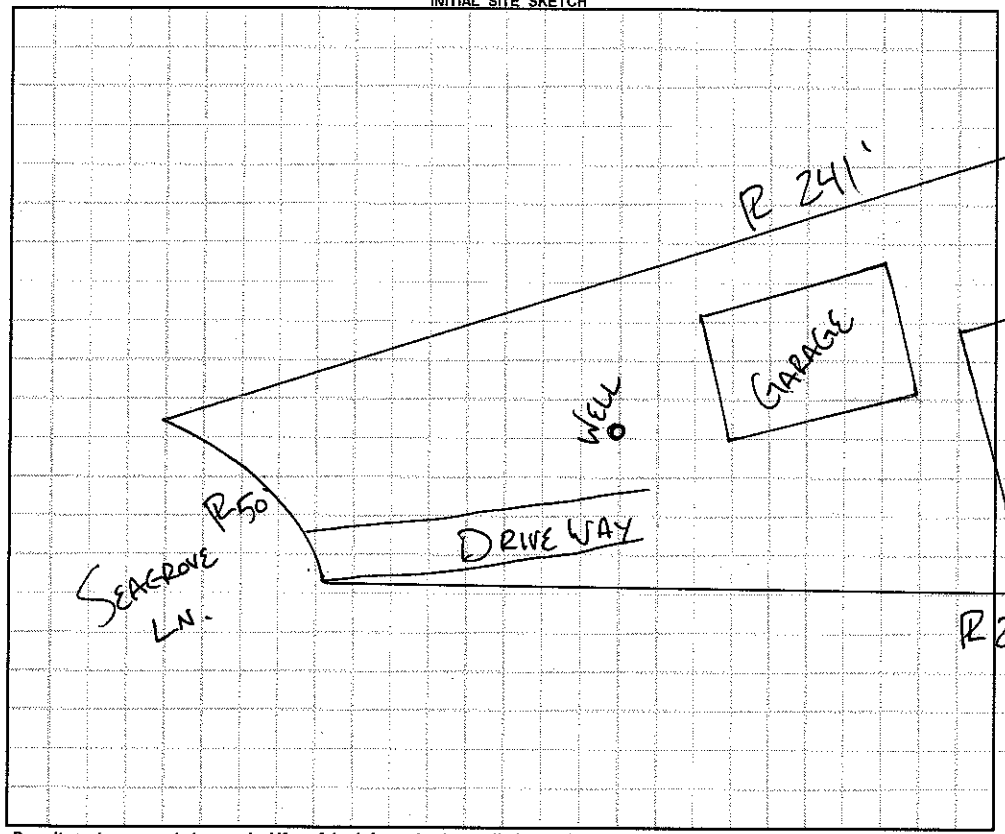

AS BUILT SKETCH

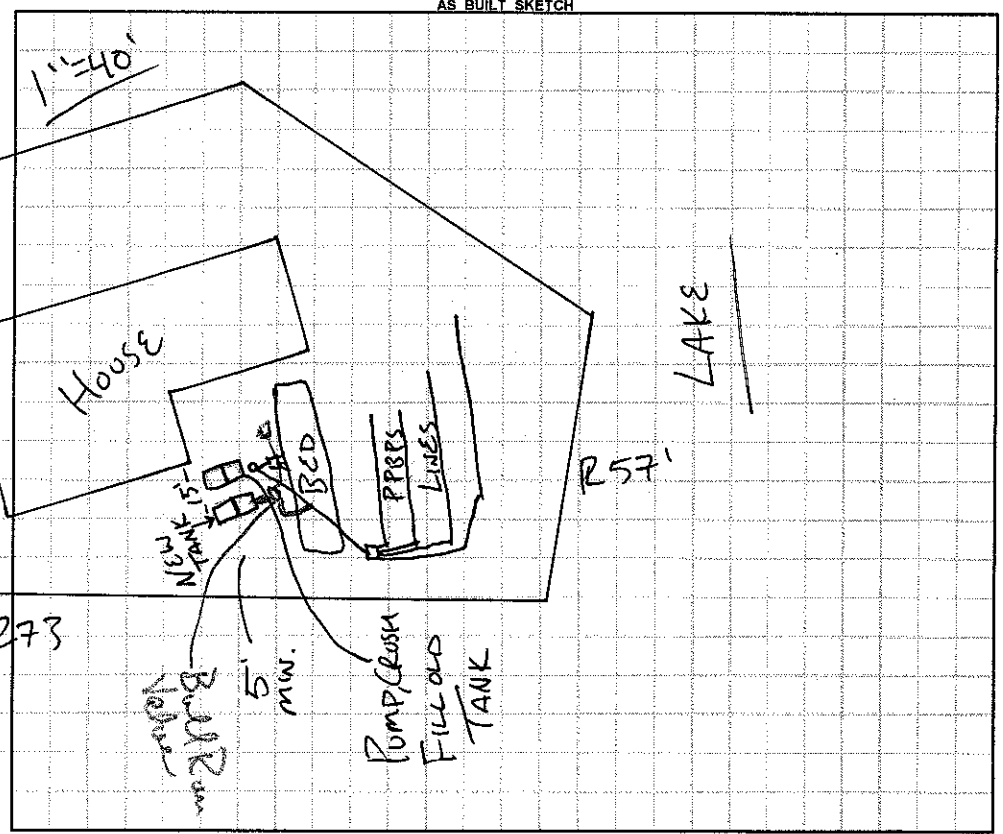

Permit can be suspended or revoked if any false information is supplied toward securing the permit / any unauthorized changes are made to the site / any unauthorized changes are made in the installation of the system. **CONTACT A LOCATOR SERVICE PRIOR TO ANY EXCAVATION**

☐ **IMPROVEMENT PERMIT** *with plat valid without expiration.* ☒ **IMPROVEMENT PERMIT** *with site plan valid for 60 mos.* ☒ **AUTHORIZATION TO CONSTRUCT** *valid for period equal to IMPROVEMENT PERMIT--not to exceed 60 mo.*

Owner / Applicant Signature: Date: 10/24/16 Installed by: T W Simmons

IMPROVEMENT PERMIT by: Date: 10-13-16 OPERATION PERMIT by: W Sparks Date: 10/25/16

AUTHORIZATION TO CONSTRUCT by: Date: 10-13-16 Existing System Inspected by: Date:

Health Dept. Copy - WHITE Applicant (Final Approval) - YELLOW Applicant (Conditional Approval) - PINK