IREDELL COUNTY HEALTH DEPARTMENT

STATESVILLE 704-878-5305 50.00 Paid 3.00 MOORESVILLE 704-664-5281

IMPROVEMENT PERMIT / AUTHORIZATION TO CONSTRUCT / OPERATION PERMIT / EXISTING SYSTEM INSPECTION

PERMIT# 070452 PIN# 4626 52 4166 DATE 12/27/02

OWNER OR CONTRACTOR JOSEPH MIDKIFF PHONE: Business Home 664-3400

ADDRESS 396 WILLIAMSON RD. MOORESVILLE, NC. 28115

LOCATION 1100, TR CHUCKWOOD TR SEAGROVE TO CULDESAC LOT ON (R)

SUBDIVISION HOLIDAY HARBOR BLOCK / SECTION LOT 13 LOT AREA .49AC SITE CLASS PS DESIGN FLOW 360 L.T.A.R. .3

Septic Tank: 1000 / 1000 Gallons; STB 794 Date 5-30-03

Pump Tank: 1000 Gallons; PT 794 Date 5-30-03

Pump Make: Model Serial No.

Nitrification Field: No Fields 1 Square Feet 400 * Linear Feet 200 *

No Lines 4@50' Trench Width 2-3' Max Trench Bottom Depth 3' Gravel Depth No

[X] New System [ ] Repair System Type: I, II, [III], IV, V, VI

System Description: 16" DPBPS W GRINDER PUMP

Repair System Description: SAME

Maintenance Agreement Required: [ ] Yes [X] No

[X] House/Mod. Home No. Bedrooms 3

[ ] Mobile Home No. Bathrooms

[ ] Business No. Employees

[X] Other 1BD. EXISTING

[ ] Slab [X] Crawl Space [ ] Basement w/plumbing [ ] Basement wo/plumbing


Water Supply: [X] Individual [ ] Public [ ] Community

Comments/Conditions:


(11=46')

Comments/Conditions: Note: Some scattered rock in ditches

INITIAL SITE SKETCH

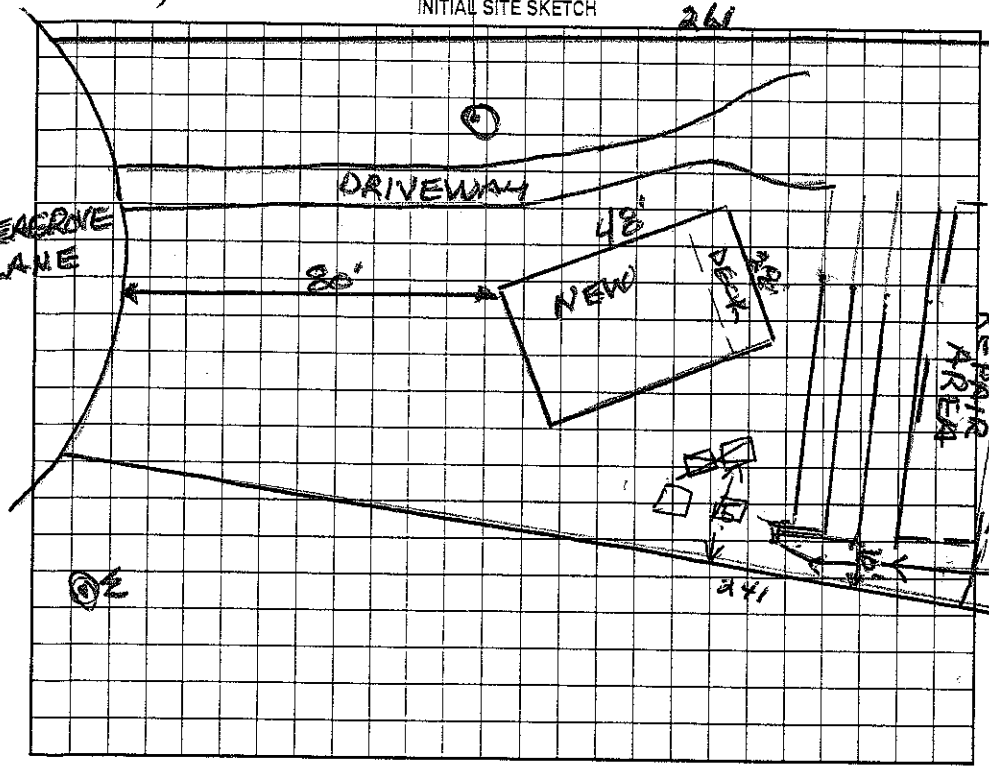

AS BUILT SKETCH

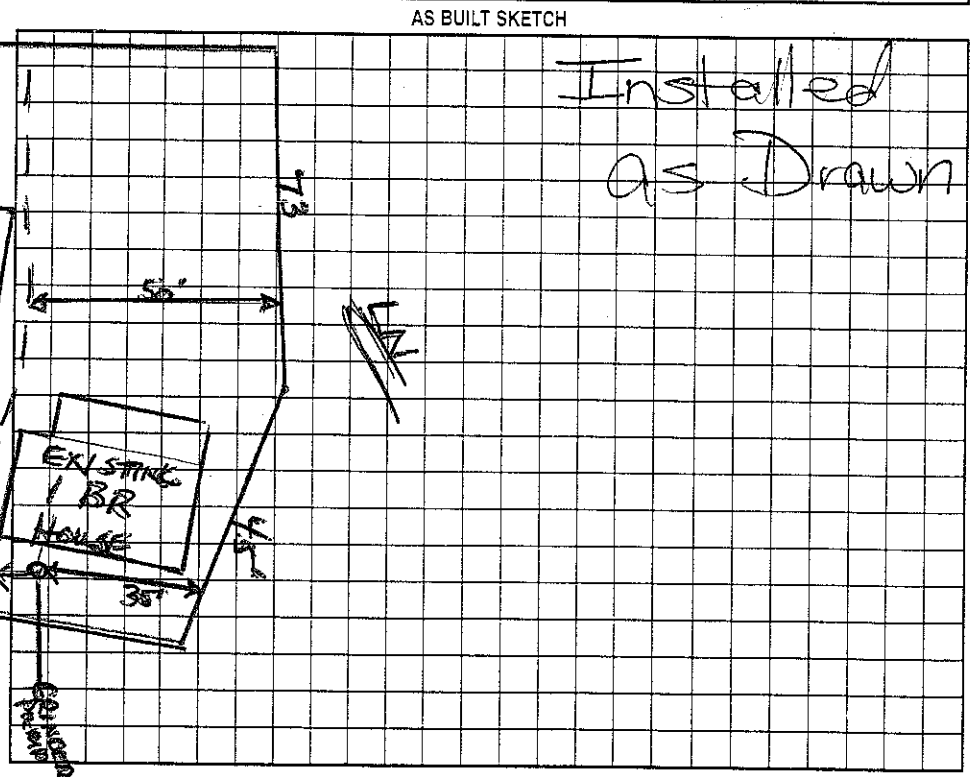

Permit can be suspended or revoked if any false information is supplied toward securing the permit/any unauthorized changes are made to the site/any unauthorized changes are made in the installation of the system. Improvement Permit with plat valid without expiration. Improvement Permit with site plan valid for sixty months. Authorization to Construct is valid for a period equal to that of Improvement Permit – not to exceed sixty months.

Signed: X Danny H. Ocean date 3/19/03 Installed by: Richard Abernathy R.S.

Improvement Permit by: Wesley Sparks R.S. date 12/27/02 Operation Permit by: Maine HH Dobson R.S. date 7/3/03

Authorization to Construct by: Wesley Sparks R.S. date 12/27/02 Existing System Inspection by: date

HEALTH DEPT. COPY: WHITE OWNER COPY (FINAL): YELLOW OWNER COPY (INITIAL): PINK