IREDELL COUNTY HEALTH DEPARTMENT

Statesville Phone TR 3-7271 Mooresville Phone NO 3-1271

PERMIT TO INSTALL SEPTIC TANK

Permit NO. _____ Permit Date 1 Nov. 1967

Owner Mr. Snouse Address _____

Installed By Dalvinson Address Mooresville, N.C.


Location of Property Holiday Harbor. Lot 12

Tank		Capacity		Length of Lines		Fixtures	
Block	( )	1000	( )	225'	( )	No. of Baths	( )
Precast	(X)	1250	( )	250'	( )	Dishwasher	( )
		1500	( )	Other _____		Garbage Grdr.	( )
		Other _____				Other _____	

NOTIFY HEALTH DEPARTMENT AT LEAST EIGHT HOURS BEFORE TANK IS TO BE INSPECTED.

Final Inspection 1 Nov. 1967 Approved (X) Disapproved ( )

Remarks L4/Lr

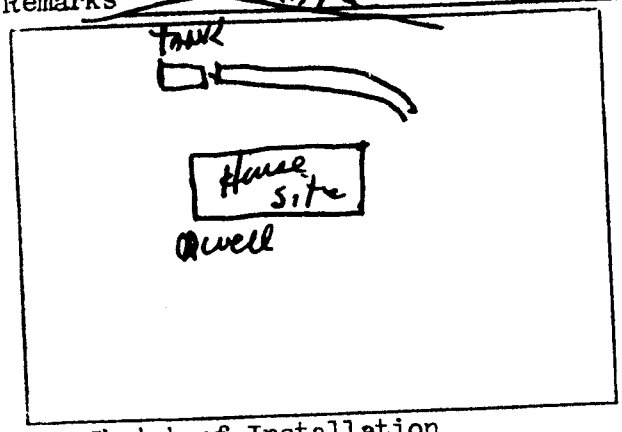

Sketch of Installation

Sanitarian