IREDELL COUNTY HEALTH DEPARTMENT

STATESVILLE 704-878-5305 MOORESVILLE 704-664-5281

IMPROVEMENT PERMIT / AUTHORIZATION TO CONSTRUCT / OPERATION PERMIT / EXISTING SYSTEM INSPECTION

PERMIT# 109030 PIN# 4626525727 Gary Deese Neighbor DATE 10/16/2002

OWNER OR CONTRACTOR David Wimer PHONE: Business 664-6249 Home 215 493-3560

ADDRESS 111 Walker Rd Washington PA

LOCATION Brawley School Rd TR Southfork bear to left when Rd splits on right

SUBDIVISION CLAY TY BLOCK / SECTION 8 LOT 10 LOT AREA SITE CLASS. PS DESIGN FLOW 360 L.T.A.R. #306

Septic Tank: Existing Gallons; STB Date

Pump Tank: Gallons; PT Date

Pump Make: Model Serial No.

Nitrification Field: No Fields Square Feet Linear Feet

No Lines Trench Width Exist Max Trench Bottom Depth Gravel Depth

☐ New System ☐ Repair System Type: I II III IV V VI

System Description: Existing Gravity Convention

Repair System Description:

Maintenance Agreement Required: ☐ Yes ☒ No

☐ House/Mod. Home No. Bedrooms 3

☒ Mobile Home No. Bathrooms 2

☐ Business No. Employees

☐ Other


☐ Slab ☒ Crawl Space ☐ Basement w/plumbing ☐ Basement wo/plumbing

Water Supply: ☒ Individual ☐ Public ☐ Community

Comments/Conditions: Existing Drainfield appears to be functioning okay at time of inspection. No problems Noticeable.

Comments/Conditions: Note: Approved for 3 Bedroom House in 1996. (Septic System last checked 8/96 for Ronald Scott) by W.S.

INITIAL SITE SKETCH ☒ Not to Scale

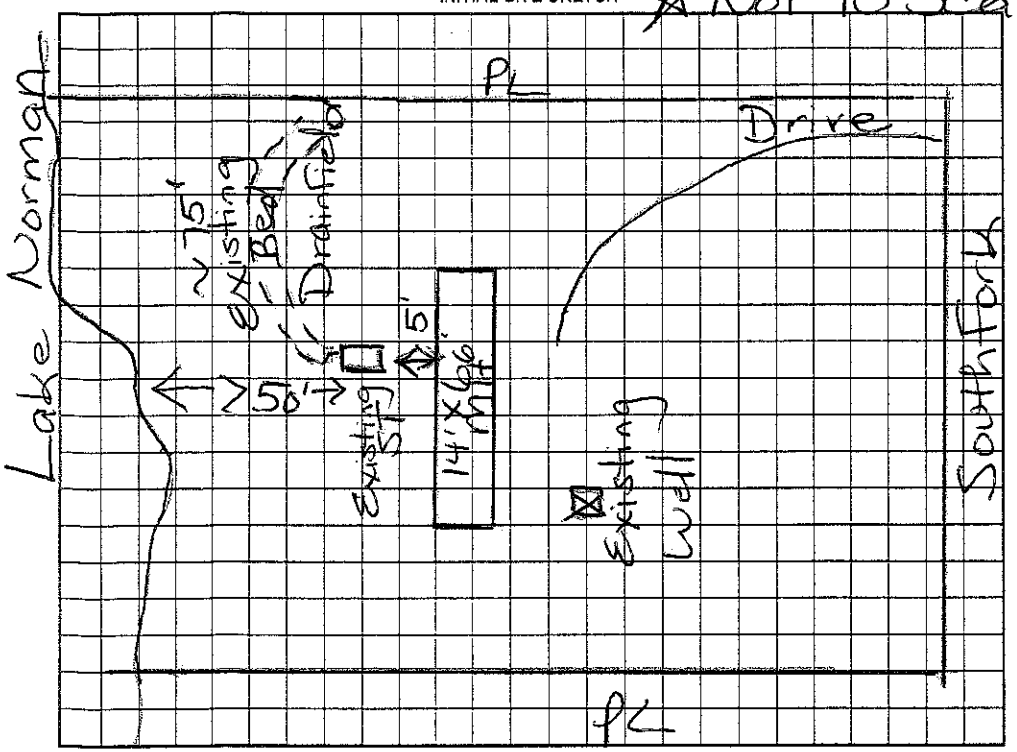

AS BUILT SKETCH

Note: Keep new MH at least 5' from Septic System

Permit can be suspended or revoked if any false information is supplied toward securing the permit/any unauthorized changes are made to the site/any unauthorized changes are made in the installation of the system. Improvement Permit with plat valid without expiration. Improvement Permit with site plan valid for sixty months. Authorization to Construct is valid for a period equal to that of Improvement Permit – not to exceed sixty months.

Signed: ☒ Gary Deese date 10/14/2002 Installed by:

Improvement Permit by: Maria H. Dobson R.S. date 10/16/2002 Operation Permit by: date

Authorization to Construct by: date Existing System Inspection by: Maria H. Dobson R.S. date 10/16/2002

HEALTH DEPT. COPY: WHITE OWNER COPY (FINAL): YELLOW OWNER COPY (INITIAL): PINK