IREDELL COUNTY HEALTH DEPARTMENT

STATESVILLE 704-878-5305 MOORESVILLE 704-664-5281

IMPROVEMENT PERMIT / CERTIFICATE OF COMPLETION / OPERATION PERMIT / EXISTING SYSTEM INSPECTION

PROPERTY DESCRIPTION NO. 24694 DATE 8/20/96 TAX MAP NO. 2F 2A 10 Watershed: ☒ Yes ☐ No

OWNER OR CONTRACTOR Ronald Scott PHONE: Business Home 892-9673

ADDRESS c/o Jim Murphy PO Box 2383 Conyers, NC. 28031

LOCATION Brawley School Rd. To South Fork (L) Catford, 5th Lot on (R) past Bennett Lane

SUBDIVISION C L + T BLOCK / SECTION 8 LOT 10 LOT AREA 20,000 FT² SITE CLASS. — DESIGN FLOW 360 L.T.A.R.

Septic Tank: Existing Gallons; STB Date

Pump Tank: Gallons; PT Date

Pump Make: Model Serial No.

Nitrification Field: No Fields Square Feet Linear Feet

No Lines Trench Width Existing Drain Field Max Trench Bottom Depth Gravel Depth

☐ New System ☐ Repair System Type: I II III IV V VI

System Description: Existing System

Repair System Description:

Maintenance Agreement Required: ☐ Yes ☐ No

☐ House/Mod. Home ☒ Mobile Home ☐ Business ☐ Other

No. Bedrooms 3 No. Bathrooms 2 No. Employees

☐ Slab ☐ Crawl Space ☐ Basement w/plumbing ☐ Basement wo/plumbing


Water Supply: ☒ Individual ☐ Community ☐ Public

Comments:

Comments:
No Completion Found - No evidence of malfunction
See attached copy of 1976 permit - gm 9-1-09

INITIAL SITE SKETCH

AS BUILT SKETCH

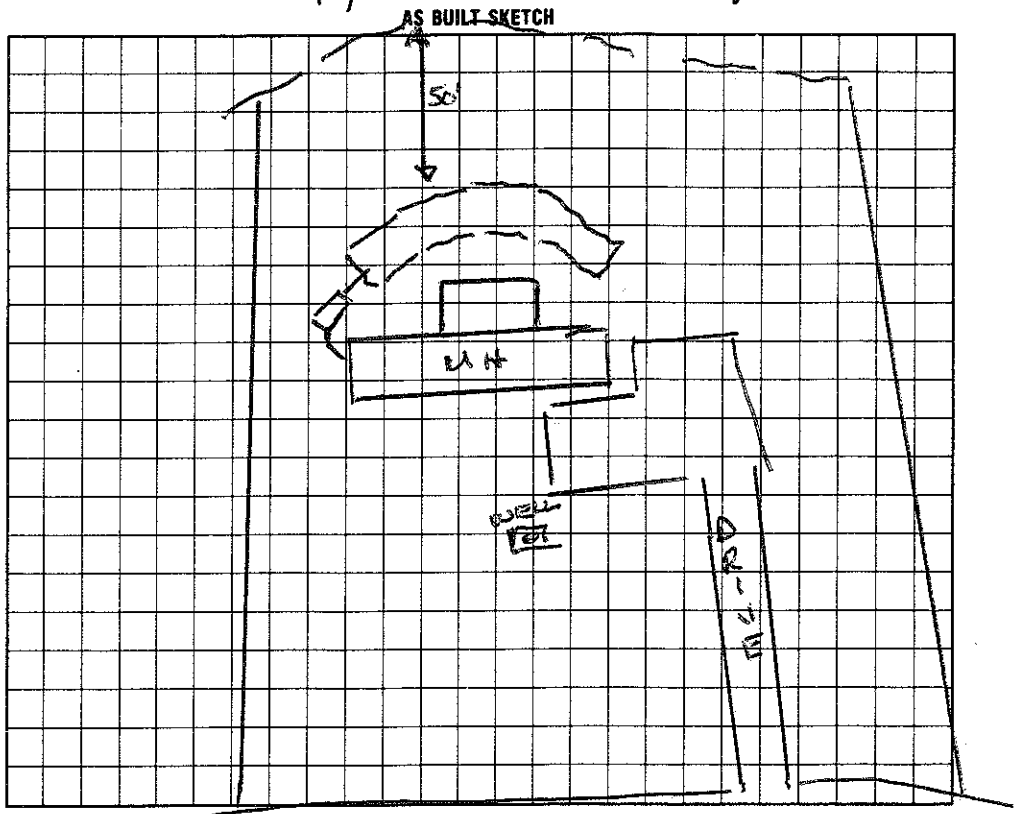

I understand that this permit can be suspended or revoked if any false information is supplied toward securing the permit/any unauthorized changes are made to the site/any unauthorized changes are made in the installation of the system.

Signed:

Improvement Permit by: date

Existing System Inspection by: date

Installed by:

Certificate of Completion by: Existing System Wesley Sparks RS. date 8/20/96

Operation Permit by: date

HEALTH DEPT. COPY: WHITE INSPECTION COPY (FINAL): GREEN OWNER COPY (FINAL): YELLOW INSPECTION COPY (INITIAL): PINK OWNER COPY (INITIAL): GOLD