IREDELL COUNTY HEALTH DEPARTMENT

STATESVILLE 704-878-5305 MOORESVILLE 704-664-5281

IMPROVEMENT PERMIT / AUTHORIZATION TO CONSTRUCT / OPERATION PERMIT / EXISTING SYSTEM INSPECTION

PERMIT# 075068 PIN# 4626526009 DATE 7/31/98

OWNER OR CONTRACTOR JAMES RINEHART PHONE: Business _____ Home 536-8523

ADDRESS 7108 PRESTON CT. CHARLOTTE NC 28215

LOCATION BRAWLEY - TR CHUCKWOOD - TL SEAGROVE AT END

SUBDIVISION HOLIDAY HARBOR BLOCK / SECTION _____ LOT 11 LOT AREA ~ SITE CLASS. RS DESIGN FLOW 360 L.T.A.R. .3

Septic Tank: 1000 Gallons; STB 1012 Date 2-23-99
Pump Tank: _____ Gallons; PT _____ Date _____
Pump Make: _____ Model _____ Serial No. _____
Nitrification Field: No Fields 1 Square Feet 400 Linear Feet 200
No Lines 4@50' Trench Width 24" Max Trench Bottom Depth 28" Gravel Depth NA

☑ New System ☐ Repair System Type: I, II, III, IV, V, VI
System Description: GRAVITY ~~PRESS~~ Chambers
Repair System Description: DEEPED BY 6'3'
Maintenance Agreement Required: ☐ Yes ☑ No


☑ House/Mod. Home No. Bedrooms 3
☐ Mobile Home No. Bathrooms 2
☐ Business No. Employees _____
☐ Other _____
☐ Slab ☐ Crawl Space ☑ Basement w/plumbing ☐ Basement wo/plumbing

Water Supply: ☑ Individual ☐ Public ☐ Community


Comments:/Conditions:

Comments:/Conditions:

INITIAL SITE SKETCH

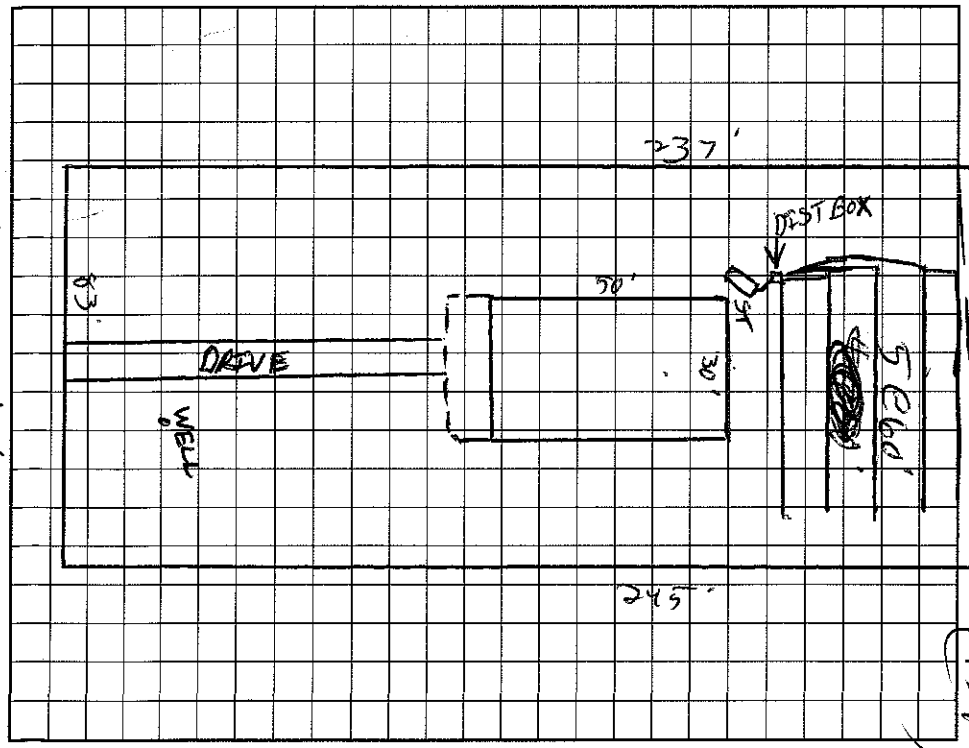

AS BUILT SKETCH

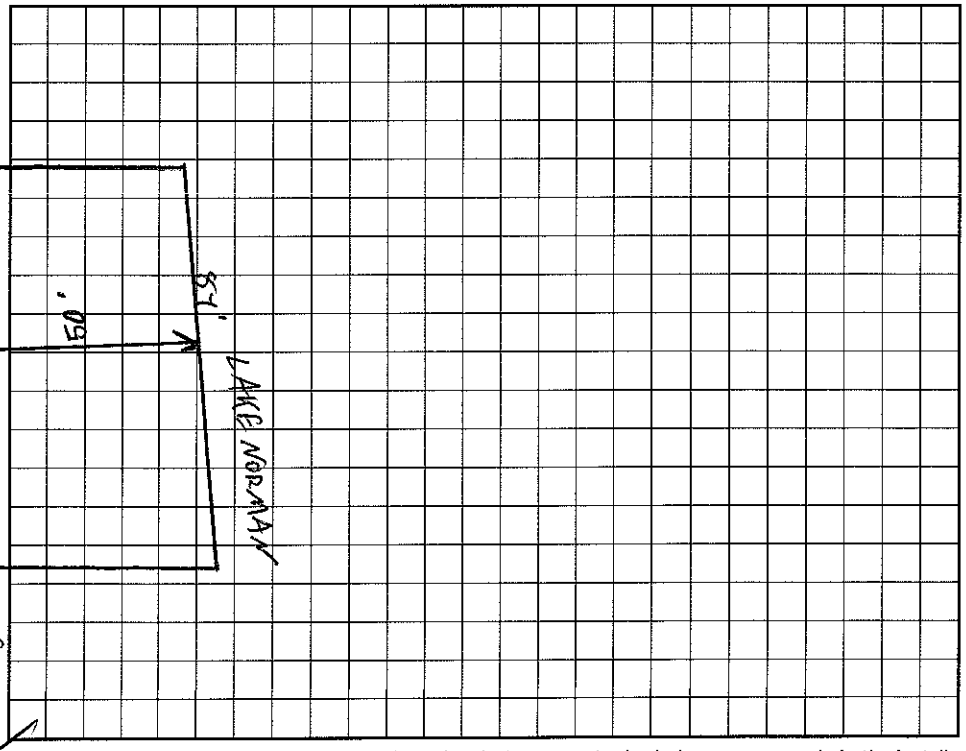

SEAGROVE L.N.

I understand that this permit can be suspended or revoked if any false information is supplied toward securing the permit/any unauthorized changes are made to the site/any unauthorized changes are made in the installation of the system. Improvement Permit with plat valid without expiration. Improvement Permit with site plan valid for sixty months. Authorization to Construct is valid for a period equal to that of Improvement Permit – not to exceed sixty months.

Signed: James M Rinehart date 7/31/98 Installed by: _____

Improvement Permit by: C. [illegible] RS date 7/31/98 Operation Permit by: Jeff Moyer date 3/24/99

Authorization to Construct by: C. [illegible] RS date 7/31/98 Existing System Inspection by: _____ date _____

HEALTH DEPT. COPY: WHITE INSPECTION COPY (FINAL): GREEN OWNER COPY (FINAL): YELLOW INSPECTION COPY (INITIAL): PINK OWNER COPY (INITIAL): GOLD