IREDELL COUNTY HEALTH DEPARTMENT

STATESVILLE 704-878-5305 — MOORESVILLE 704-[illegible]51

IMPROVEMENT PERMIT / AUTHORIZATION TO CONSTRUCT / OPERATION PERMIT / EXISTING SYSTEM INSPECTION

PERMIT# 112498 PIN# 4626-66-37-15-220 4626-52-9925 DATE 5-2-05

OWNER OR CONTRACTOR Crescent Resource / ES JOHNSON PHONE: Business 6060-1185 Home

ADDRESS 2214 Brawley School Rd Mooresville, NC 28117

LOCATION Brawley School Rd TR Southfork TL Freshwater TR Ragsdale TL Braxton Ct on Rt

SUBDIVISION The Farms BLOCK / SECTION 2 LOT 220/226 LOT AREA 1.16 Acre + SITE CLASS. PS DESIGN FLOW 480 gpd T.A.R. .3

Septic Tank: 1000 + Gallons; STB 338 Date 2-14-06

Pump Tank: 1000 Gallons; PT 283 Date 10-8-05

Pump Make: Myers Model ME50 Serial No.

Nitrification Field: No Fields 1 Square Feet 540-810' Linear Feet 270'

No Lines 4 Trench Width 24"-36" Max Trench Bottom Depth 36"

☒ New System ☐ Repair System Type: I, II, III, (IV), V, VI

System Description: Pump-Lf-Panel Block Offsite

Repair System Description: Pump 25%-50% Rocks

Maintenance Agreement Required: ☒ Yes ☐ No

Gravel Depth N/A ☐ Slab ☐ Crawl Space ☐ Basement w/plumbing ☐ Basement wo/plumbing

☒ House/Mod. Home ☐ Mobile Home ☐ Business ☐ Other


No. Bedrooms 4 No. Bathrooms 4 No. Employees

Water Supply: ☐ Individual ☒ Public ☒ Community

Comments:/Conditions:

Scale 1:50'

INITIAL SITE SKETCH

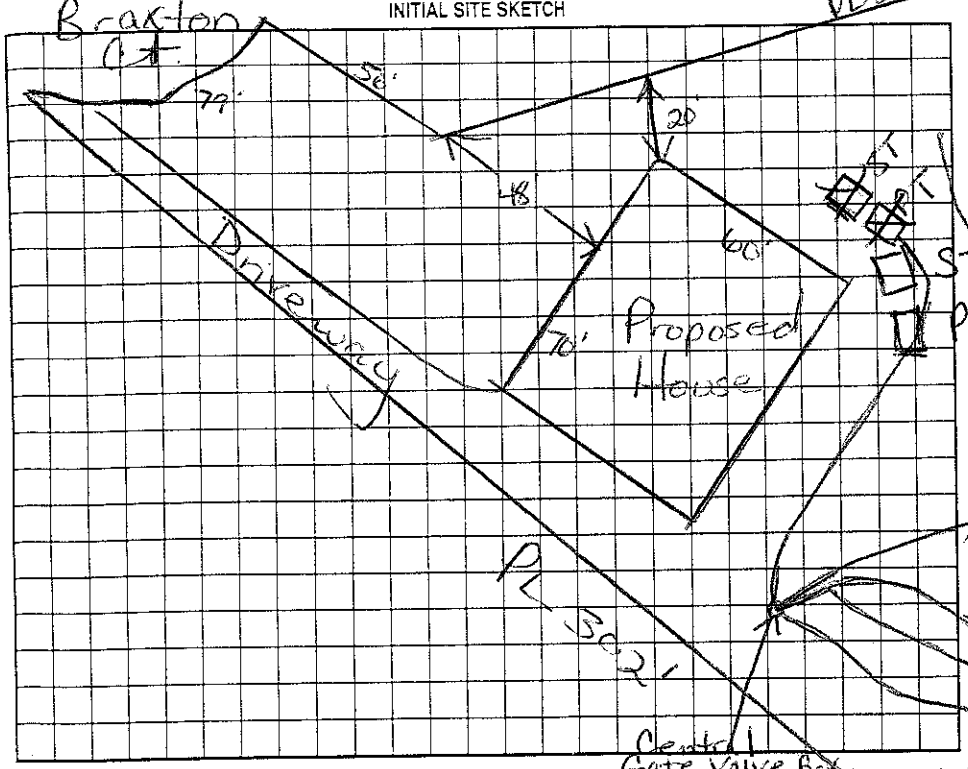


Comments:/Conditions:

Cheaked tanks & lines 3/30/06

3/16" hole drilled

AS BUILT SKETCH

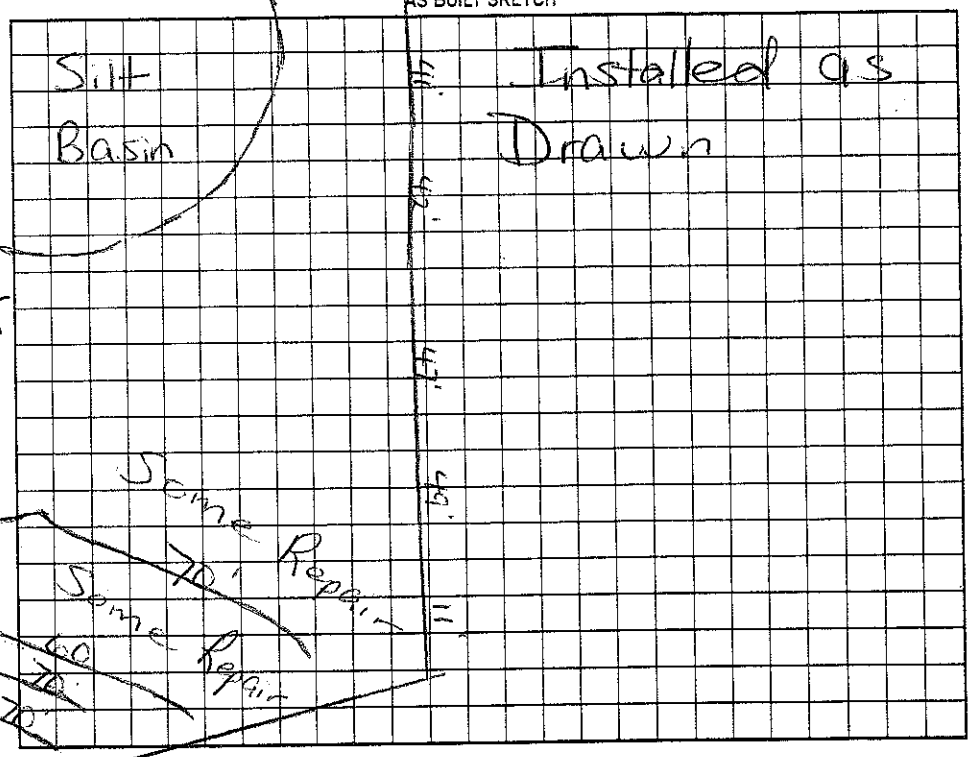

Permit can be suspended or revoked if any false information is supplied toward securing the permit, any unauthorized changes are made to the site/any unauthorized changes are made in the installation of the system. Improvement Permit with plat valid without expiration. Improvement Permit with site plan valid for sixty months. Authorization to Construct is valid for a period equal to that of Improvement Permit – not to exceed sixty months.

Signed: Kathleen Davey date 5/6/05 Installed by: Willie Christensbury RS date 5/26/06

Improvement Permit by: Maina H. Johnson RS date 5/2/05 Operation Permit by: Maina H. Johnson

Authorization to Construct by: Wesley Sparks RS. date 9/13/05 Existing System Inspection by: date

HEALTH DEPT. COPY: WHITE OWNER COPY (FINAL): YELLOW OWNER COPY (INITIAL): PINK