4626531583

IREDELL COUNTY HEALTH DEPARTMENT

STATESVILLE 704-878-5305 MOORESVILLE 704-664-5281

IMPROVEMENT PERMIT / AUTHORIZATION TO CONSTRUCT / OPERATION PERMIT / EXISTING SYSTEM INSPECTION

PERMIT# 112485 PIN# 4626 63 7315.214 DATE 6/3/06

OWNER OR APPLICANT Lake Norman Signature Homes PHONE: Business _____ Home _____

ADDRESS 5-84 Brawley School Rd STE 104

LOCATION BSR, TR South Fork, TL Freshwater TR Ragsdale, at End

SUBDIVISION Farms BLOCK / SECTION 2 LOT 214 LOT AREA 1.60 AC SITE CLASS. PS DESIGN FLOW 600 L.T.A.R. 0.3

Septic Tank: 1500 Gallons; STB 338 Date 4/13/06
Pump Tank: _____ Gallons; PT _____ Date _____
Pump Make: _____ Model _____ Serial No. _____
Nitrification Field: No Fields ___ Square Feet 1500 Linear Feet 500
No Lines 4@125' Trench Width 36" Max Trench Bottom Depth 36"

☒ New System ☐ Repair ☐ Expansion System Type: I ☒II III IV V VI
System Description: 25% Reduction
Repair System Description: Same
Maintenance Agreement Required: ☐ Yes ☒ No

☒ House/Mod. Home No. Bedrooms 5
☐ Mobile Home No. Persons ___
☐ Business No. Employees ___
☐ Other _____


Water Supply: ☐ Individual ☐ Public ☒ Community

Gravel Depth — ☒ Gravity ☒ Pressure ☐ Slab ☒ Crawl Space ☐ Basement w/plumbing ☐ Basement wo/plumbing


Comments:/Conditions:

Comments:/Conditions:

INITIAL SITE SKETCH

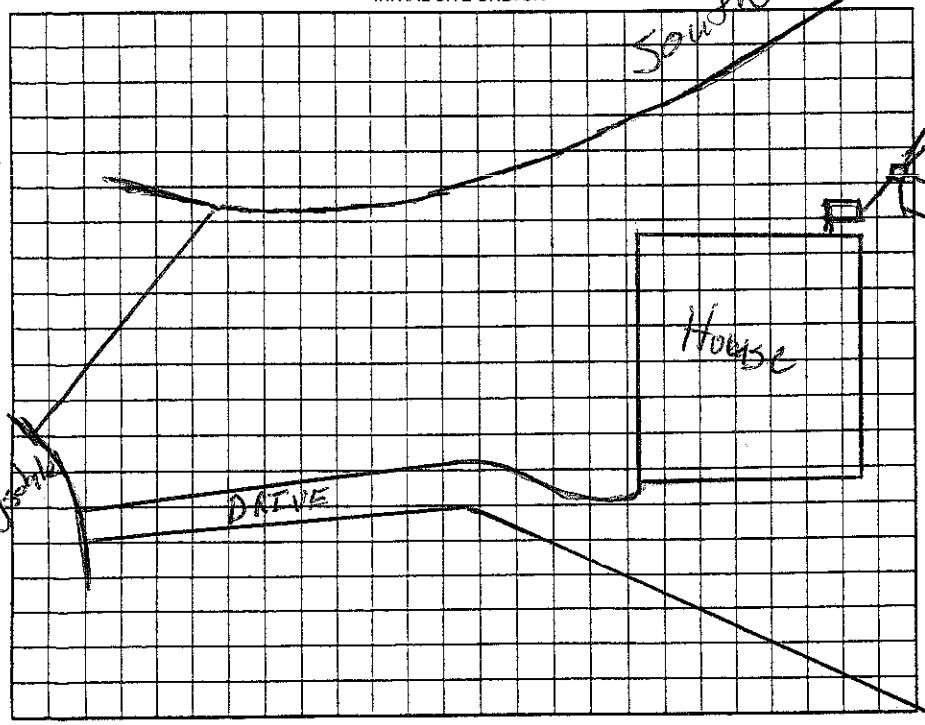

AS BUILT SKETCH

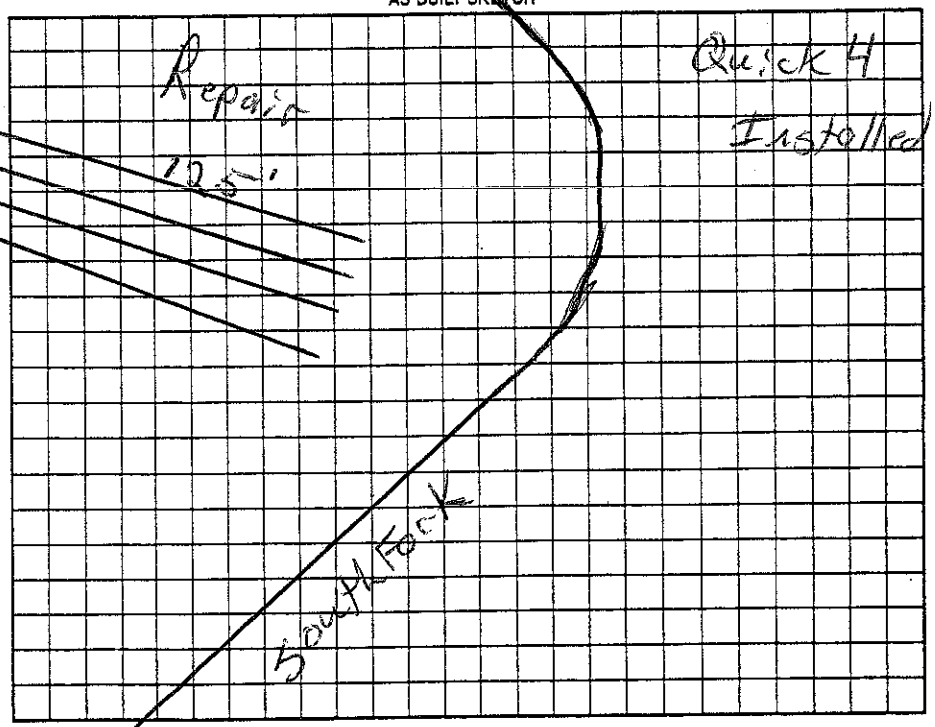

Permit can be suspended or revoked if any false information is supplied toward securing the permit/any unauthorized changes are made to the site/any unauthorized changes are made in the installation of the system. Improvement Permit with plat valid without expiration ☐ Improvement Permit with site plan valid for sixty months ☐ Authorization to Construct is valid for a period equal to that of Improvement Permit – not to exceed sixty months.

Signed: _____ date _____

Improvement Permit by: RS date 6/3/06

Authorization to Construct by: RS date 6/3/06

Installed by: Kevin Hallman

Operation Permit by: RS date 11/14/06

Existing System Inspection by: _____ date _____

HEALTH DEPT. COPY: WHITE OWNER COPY (FINAL): YELLOW OWNER COPY (INITIAL): PINK