4626534520

IREDELL COUNTY HEALTH DEPARTMENT

STATESVILLE 704-878-5305 MOORESVILLE 704-664-5281

IMPROVEMENT PERMIT / AUTHORIZATION TO CONSTRUCT / OPERATION PERMIT / EXISTING SYSTEM INSPECTION

PERMIT# 112470 PIN# 4626 63 7315.213 704-799-2976 DATE 1/26/05

OWNER OR CONTRACTOR ES Johnson Bldrs. PHONE: Business 704-361-9505 Home

ADDRESS PO Box 1402 Cornelius NC. 28031

LOCATION 1100 TR South Fork TL Freshwater TR Ragsdale on (R) at culdesac

SUBDIVISION Farms BLOCK / SECTION 2 LOT 213 LOT AREA ~.8Ac SITE CLASS PS DESIGN FLOW 480 L.T.A.R. .3

Septic Tank: 1500 Gallons; STB 338 Date 1/31/05

Pump Tank: Gallons; PT Date

Pump Make: Model Serial No.

Nitrification Field: No Fields 1 Square Feet 1200 Linear Feet 400

No Lines 5@80' Trench Width 3' Max Trench Bottom Depth 3' Gravel Depth N/A

☒ New System ☐ Repair System Type: I, II, (III), IV, V, VI

System Description: GRAVITY - 25% Reduced

Repair System Description: Pres Dosed - 16" PPBPS

Maintenance Agreement Required: ☐ Yes ☒ No

☒ House/Mod. Home No. Bedrooms 4

☐ Mobile Home No. Bathrooms 4

☐ Business No. Employees

☐ Other


☐ Slab ☒ Crawl Space ☐ Basement w/plumbing ☐ Basement wo/plumbing

Water Supply: ☐ Individual ☐ Public ☒ Community FARMS

Comments:/Conditions:

Comments:/Conditions:

INITIAL SITE SKETCH

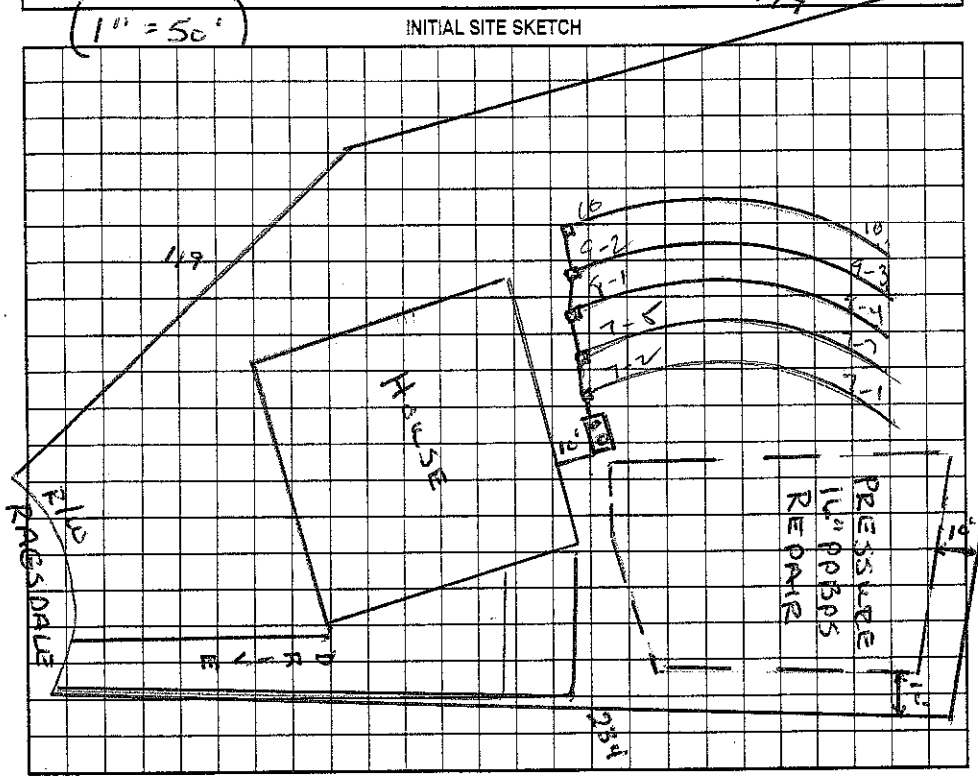

AS BUILT SKETCH

Permit can be suspended or revoked if any false information is supplied toward securing the permit/any unauthorized changes are made to the site/any unauthorized changes are made in the installation of the system. Improvement Permit with plat valid without expiration. Improvement Permit with site plan valid for sixty months. Authorization to Construct is valid for a period equal to that of Improvement Permit – not to exceed sixty months.

Signed: date

Installed by: Willie Christenbury

Improvement Permit by: Wesley Sparks R.S. date 1/26/05

Operation Permit by: Wesley Sparks R.S. date 2/16/05

Authorization to Construct by: Wesley Sparks R.S. date 1/26/05

Existing System Inspection by: date

HEALTH DEPT. COPY: WHITE OWNER COPY (FINAL): YELLOW OWNER COPY (INITIAL): PINK