IREDELL COUNTY HEALTH DEPARTMENT

STATESVILLE 704-878-5305 MOORESVILLE 704-664-5281

2430

IMPROVEMENT PERMIT / AUTHORIZATION TO CONSTRUCT / OPERATION PERMIT / EXISTING SYSTEM INSPECTION

PERMIT# 11c 491 PIN# ~~4626 63 7316.216~~ 4626-53-5116 DATE 3/24/05

OWNER OR CONTRACTOR The Hoke Company Inc PHONE: Business 704 799 7495 Home

ADDRESS PO Box 4448 Mooresville NC 28117

LOCATION BSR, TR Southfork, TL Freshwater, TR Ragsdale, on Lt at end

SUBDIVISION Farms BLOCK / SECTION 2 LOT 216 LOT AREA 1.16 AC SITE CLASS. PS DESIGN FLOW 600 L.T.A.R. 0.3

Septic Tank: ~~1000~~ 1500 Gallons; STB 338 Date 6-19-05

Pump Tank: 1000 Gallons; PT 27 Date 7-12-05

Pump Make: Myers Model ME 50 Serial No.

Nitrification Field: No Fields 1 Square Feet 990 Linear Feet 330

No Lines 4 Trench Width 24" Max Trench Bottom Depth 36" Gravel Depth —

☒ New System ☐ Repair System Type: I, II, III, (IV), V, VI

System Description: LP Panel Block

Repair System Description: Same

Maintenance Agreement Required: ☒ Yes ☐ No

☒ House/Mod. Home No. Bedrooms 5

☐ Mobile Home No. Bathrooms

☐ Business No. Employees

☐ Other


☐ Slab ☐ Crawl Space ☐ Basement w/plumbing ☐ Basement wo/plumbing

Water Supply: ☐ Individual ☐ Public ☐ Community


Comments:/Conditions:

Comments/Conditions: 8/23/05 Checked lines & tanks 8/23/05 STB PT installed in Type 3 Soils

INITIAL SITE SKETCH

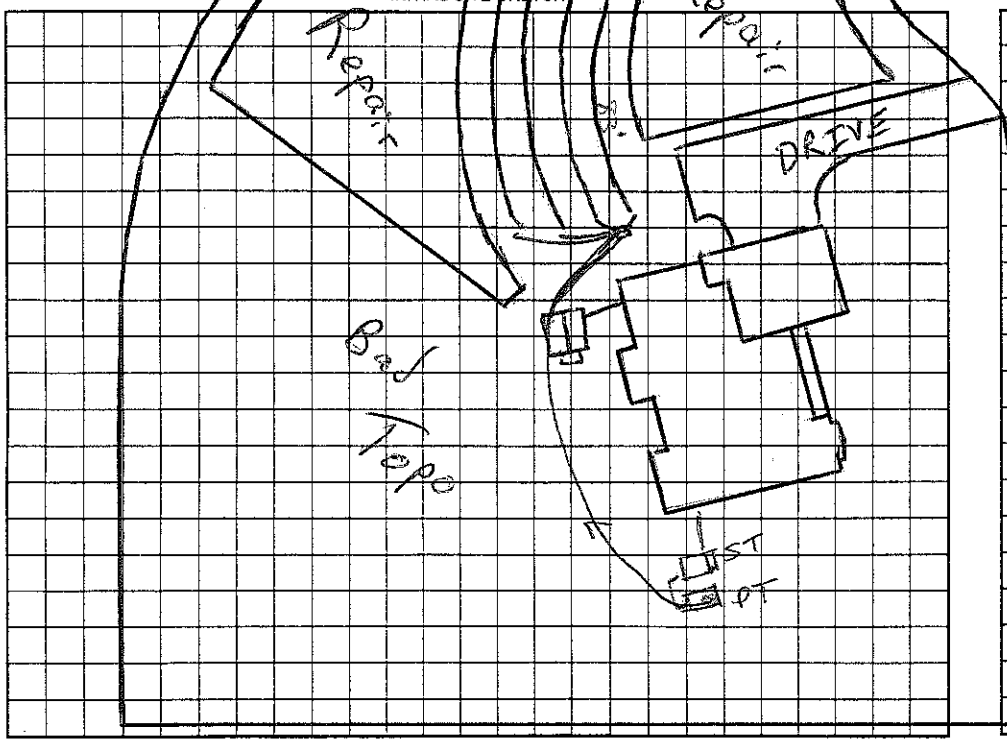

AS BUILT SKETCH

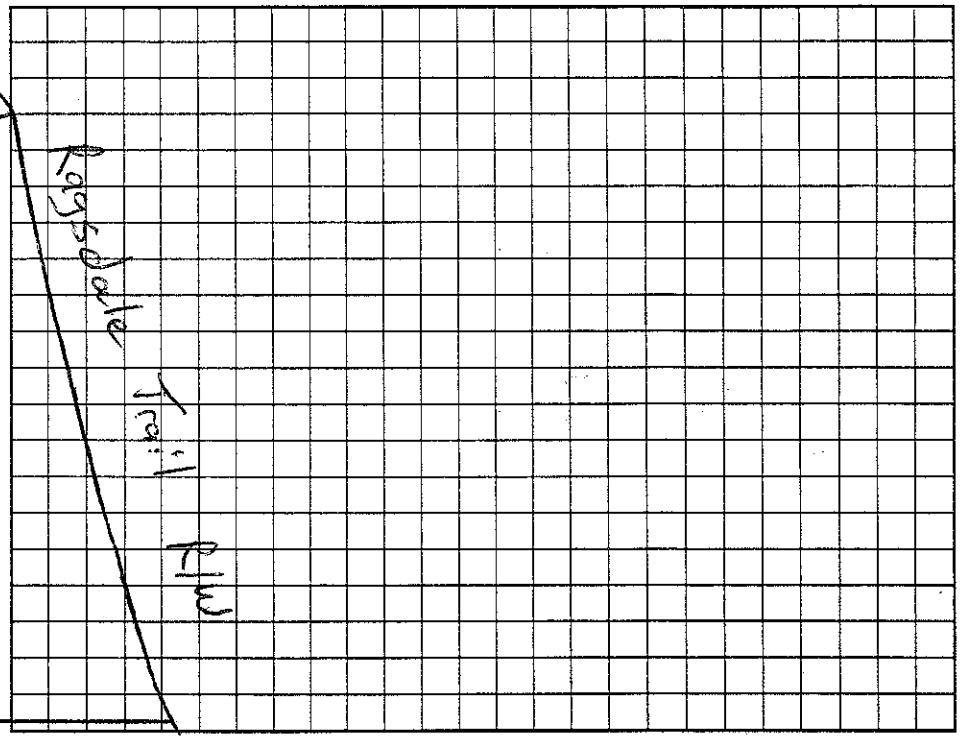

Permit can be suspended or revoked if any false information is supplied toward securing the permit/any unauthorized changes are made to the site/any unauthorized changes are made in the installation of the system. Improvement Permit with plat valid without expiration. Improvement Permit with site plan valid for sixty months. Authorization to Construct is valid for a period equal to that of Improvement Permit – not to exceed sixty months.

Signed: date 3/24/05 Installed by: R & H

Improvement Permit by: RS date 3/24/05 Operation Permit by: Wesley Sparks RS. date 11/30/05

Authorization to Construct by: RS date 3/24/05 Existing System Inspection by: date

HEALTH DEPT. COPY: WHITE OWNER COPY (FINAL): YELLOW OWNER COPY (INITIAL): PINK