4626542069

IREDELL COUNTY HEALTH DEPARTMENT

STATESVILLE 704-878-5305 MOORESVILLE 704-664-5281

IMPROVEMENT PERMIT / CERTIFICATE OF COMPLETION / OPERATION PERMIT / EXISTING SYSTEM INSPECTION

PROPERTY DESCRIPTION NO. Repair DATE 12/12/94 TAX MAP NO. Watershed: ☑ Yes ☐ No

OWNER OR CONTRACTOR Charles Davis PHONE: Business Home 366-2507

ADDRESS Aspen Rd. Mooresville NC.

LOCATION Bradley TR on South fork. Lean (R) on Aspen, 1st house on (L)

SUBDIVISION CL+T BLOCK / SECTION 8 LOT 23 LOT AREA SITE CLASS. DESIGN FLOW 240 L.T.A.R. .25

Septic Tank: 1000 Gallons; STB Date

Pump Tank: Gallons; PT Date

Pump Make: Model Serial No.

Nitrification Field: No Fields 1 Square Feet 900 Linear Feet 300

No Lines 3 Trench Width 10' Max Trench Bottom Depth >36" Gravel Depth

☐ New System ☑ Repair System Type: I (II) III, IV, V, VI

System Description: New Tank - Bed

Repair System Description:

Maintenance Agreement Required: ☐ Yes ☑ No

☑ House/Mod. Home No. Bedrooms 2

☐ Mobile Home No. Bathrooms 2

☐ Business No. Employees

☐ Other


☐ Slab ☑ Crawl Space ☐ Basement w/plumbing ☐ Basement wo/plumbing

Water Supply: ☑ Individual ☐ Community ☐ Public

Comments: Steps and walkway to be removed for installation
Septic Tank improperly plumbed - all lines must go
through septic Tank then to drainfield
Provisions for repair only

Comments:

INITIAL SITE SKETCH

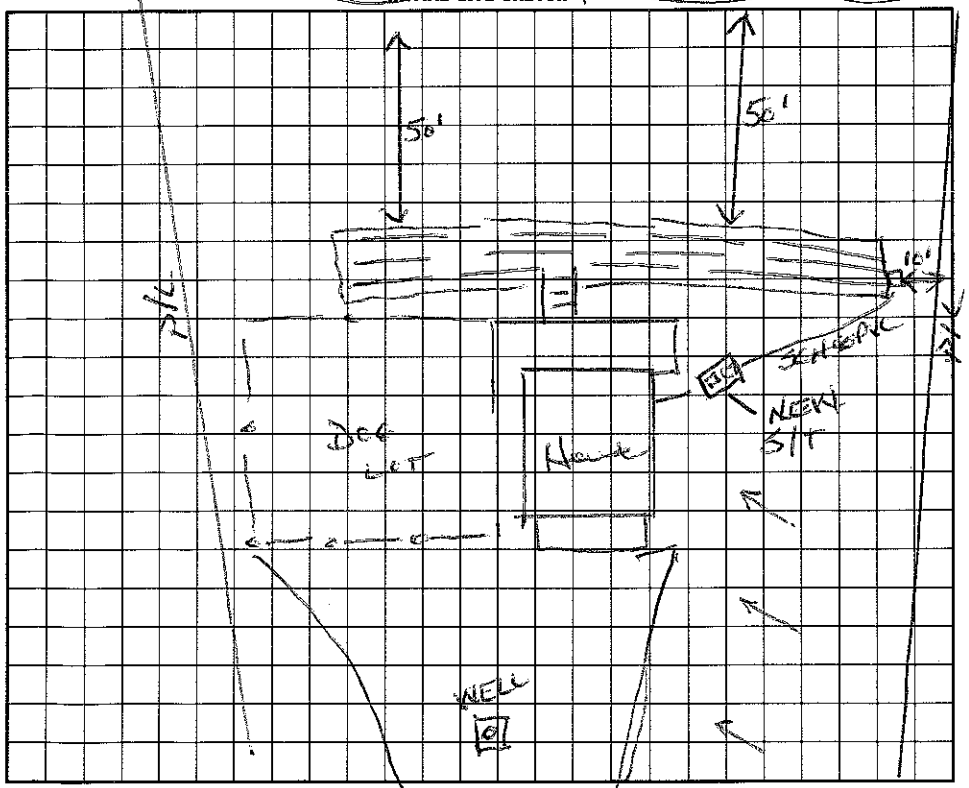

AS BUILT SKETCH

I understand that this permit can be suspended or revoked if any false information is supplied toward securing the permit/any unauthorized changes are made to the site/any unauthorized changes are made in the installation of the system. Improvement Permit is valid for 60 months from date of issuance.

Signed:

Improvement Permit by: Wesley Sparks RS date 12/12/94

Existing System Inspection by: date

Installed by: Julian Bowles

Certificate of Completion by: Wesley Sparks RS date 6/8/95

Operation Permit by: date

HEALTH DEPT. COPY: WHITE INSPECTION COPY (FINAL): GREEN OWNER COPY (FINAL): YELLOW INSPECTION COPY (INITIAL): PINK OWNER COPY (INITIAL): GOLD