IREDELL COUNTY HEALTH DEPARTMENT

Statesville Phone TR 3-7271 Mooresville Phone NO 3-1271

PERMIT TO INSTALL SEPTIC TANK

Permit No. 81 Permit Date _____ 19__

Owner Frank Mayhew Address Mooresville

Installed By Hanna Sutton Orbinson Address Mooresville


Location of Property Past John's Trading Post, Go past paved 1115. Next right, dirt rd in pines. Bear right at fork. Sect 8. Lot 24

Tank		Capacity		Length of Lines		Fixtures	
Block	( )	1000	( )	225'	( )	No. of Baths	( )
Precast	( )	1250	(✓)	250'	( )	Dishwasher	( )
		1500	( )	Other 864 sq'		Garbage Grdr.	( )
		Other _____				Other _____	

NOTIFY HEALTH DEPARTMENT AT LEAST EIGHT HOURS BEFORE TANK IS TO BE INSPECTED.

Final Inspection 7-2- 1971 Approved (✓) Disapproved ( )

Remarks No house on site

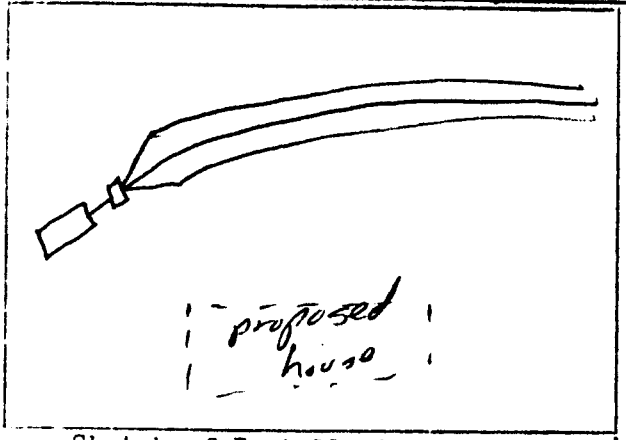

Sketch of Installation

Susan S. Hall

Sanitarian