# IREDELL COUNTY HEALTH DEPARTMENT

STATESVILLE 704-878-5305 MOORESVILLE 704-664-5281

## IMPROVEMENT PERMIT / CERTIFICATE OF COMPLETION / OPERATION PERMIT / EXISTING SYSTEM INSPECTION

PROPERTY DESCRIPTION NO. 2652 DATE July 19, '95 TAX MAP NO. 2F2A 26 4626 54 3469 Watershed: ☑ Yes ☐ No WS4

OWNER OR CONTRACTOR Charles Saunders PHONE: Business _____ Home _____

ADDRESS Cagney Rd. / Mooresville

LOCATION Brawley Fork Rd / TR Southfork Bear right on Cagney a ¼ mile on left

SUBDIVISION Crestcut BLOCK / SECTION 8 LOT 26 LOT AREA _____ SITE CLASS. _____ DESIGN FLOW 400 gpd L.T.A.R. .3

Septic Tank: 1000 Gallons; STB 144 Wellington Date 6-27-95

Pump Tank: 1000 Gallons; PT 27 Wellington Date 7-14-95

Pump Make: Hydromatic Model SF100 (1 Hp) Serial No. M2

Nitrification Field: No Fields 1 Square Feet 1200 Linear Feet 400

No Lines 4 Trench Width 36" Max Trench Bottom Depth 30" Gravel Depth NA

☑ New System ☐ Repair System Type: I, II, III, IV, V, VI

System Description: pumped Infiltrator

Repair System Description: Same

Maintenance Agreement Required: ☐ Yes ☑ No

☑ House/Mod. Home No. Bedrooms 4

☐ Mobile Home No. Bathrooms 4

☐ Business No. Employees _____

☐ Other _____

☐ Slab ☐ Crawl Space ☑ Basement w/plumbing ☐ Basement wo/plumbing


Water Supply: ☑ Individual ☐ Community ☐ Public

Comments:


Comments:

Not to Scale

**INITIAL SITE SKETCH**

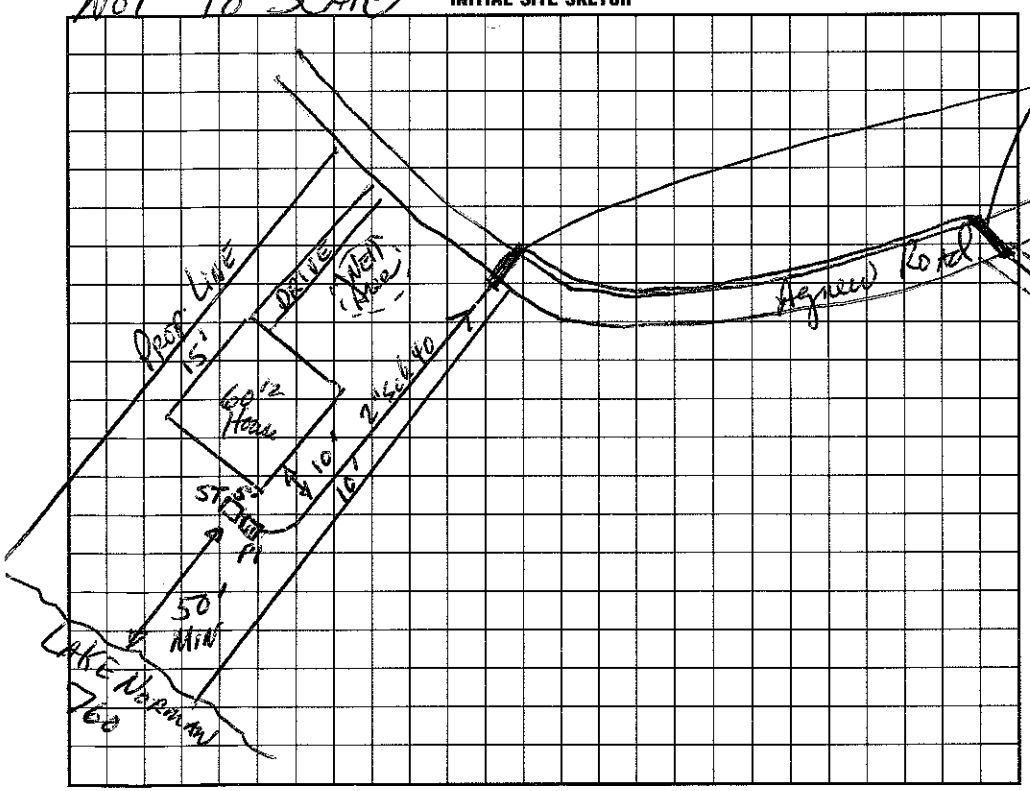


**AS BUILT SKETCH**

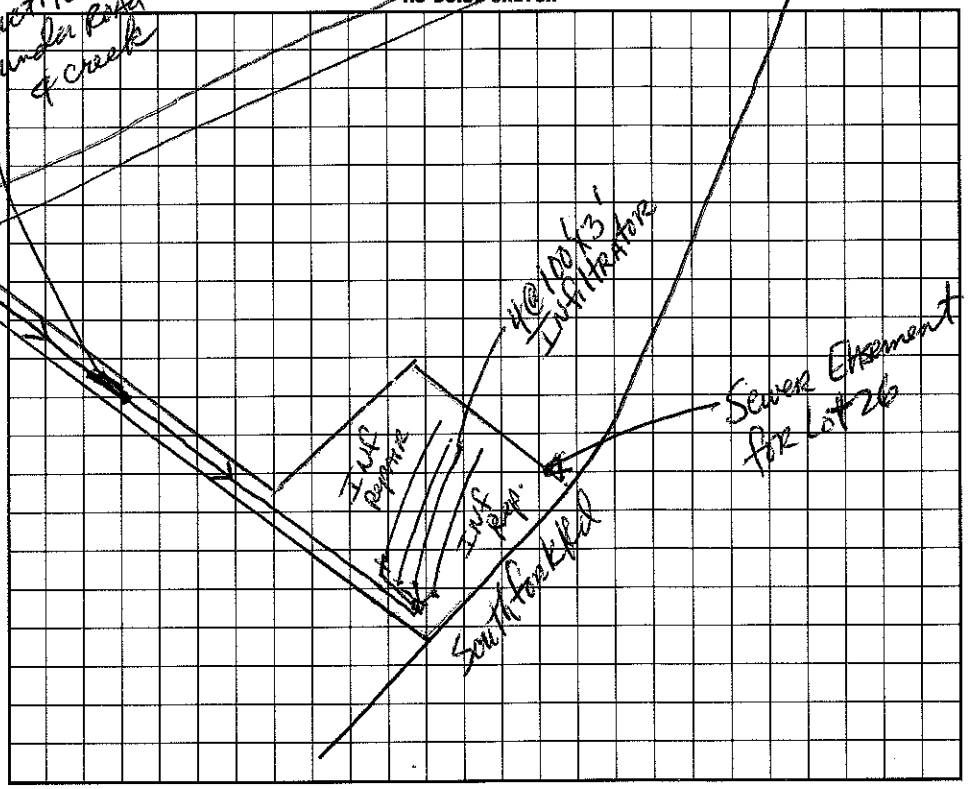


I understand that this permit can be suspended or revoked if any false information is supplied toward securing the permit/any unauthorized changes are made to the site/any unauthorized changes are made in the installation of the system. Improvement Permit is valid for 60 months from date of issuance.

Signed: _____

Improvement Permit by: _____ date 7-19-95

Existing System Inspection by: _____ date _____

Installed by: _____

Certificate of Completion by: _____ date _____

Operation Permit by: _____ date 5/31/96

HEALTH DEPT. COPY: WHITE INSPECTION COPY (FINAL): GREEN OWNER COPY (FINAL): YELLOW INSPECTION COPY (INITIAL): PINK OWNER COPY (INITIAL): GOLD