IREDELL COUNTY HEALTH DEPARTMENT

STATESVILLE 704-878-5305 MOORESVILLE 704-664-5281

As Built

IMPROVEMENT PERMIT / AUTHORIZATION TO CONSTRUCT / OPERATION PERMIT / EXISTING SYSTEM INSPECTION

PERMIT # 171481 PIN # 4626545752 DATE 6-29-2012

OWNER or APPLICANT Francisco Alvarado PHONE: Business Home:

OWNER or APPLICANT ADDRESS 4215-B Stewart Andrew Blvd. Charlotte, NC 28217

LOCATION / DIRECTIONS Brawley School Rd TR Southfork, Stay to right on Agney on left #163

SUBDIVISION Cl@T BLOCK / SECTION 8 LOT# 28 LOT AREA 42372ft DESIGN FLOW 360gpd L.T.A.R. .3-.325

Septic Tank * 1000 Gallons: STB IM1060 Date

Pump Tank Gallons: PT Date

Pump Make Model Serial #

Nitrification Field No Fields 1 No Lines 3 Linear Feet 275ft

Trench Width 36" Max. Trench Bottom Depth Gravel Depth N/A

☒ New System ☐ Repair ☐ Expansion System Type I II (III) IV V VI

System Description: Gravity-25% Reduction

Repair System Description: Modified Conventional

Maintenance Agreement Required ☐ YES ☒ NO

☒ GRAVITY ☐ PRESSURE


☒ Residence No. Bedrooms 3 ☐ Business No. Persons ☐ Other No. Employees ☐ Slab ☒ Crawl Space ☐ Basement w/plumbing ☐ Basement w/o plumbing

Water Supply: ☒ Private ☐ Public ☐ Community


Comments / Conditions: Note: Addition built over Existing Septic therefore new System was required A Hit large areas of rock while digging drainfield so drainfield layout had to be altered/revised

Comments / Conditions: * Installed Plastic Infiltrator ST Multi port 70-1431 IDC3 1090 6/28/12 Checked lines

INITIAL SITE SKETCH

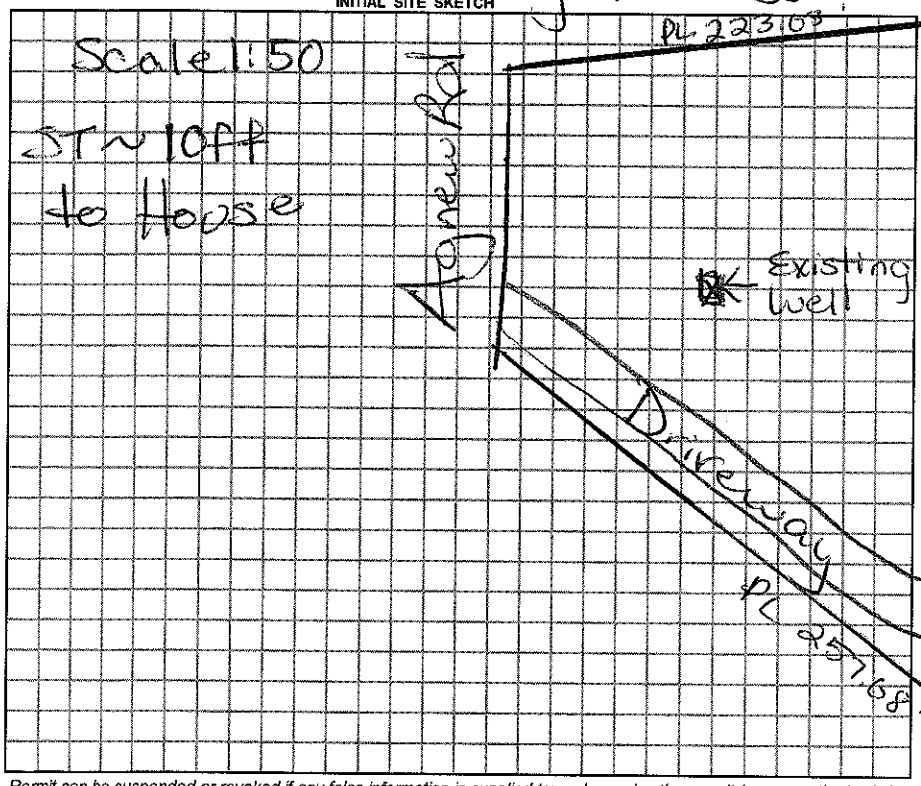

AS BUILT SKETCH

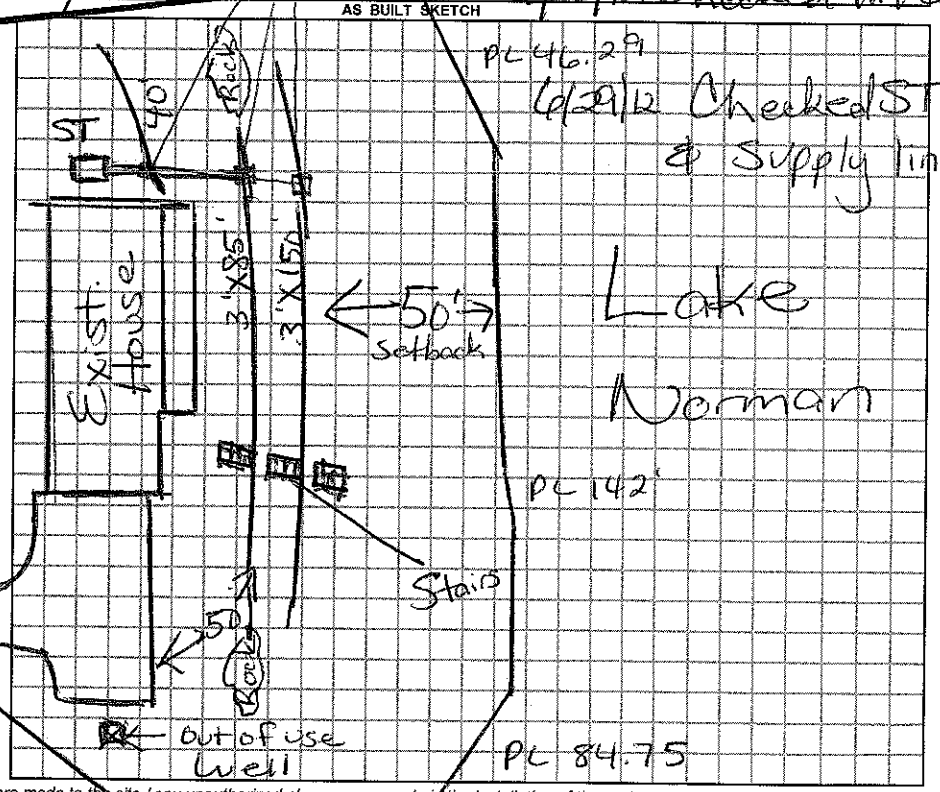

Permit can be suspended or revoked if any false information is supplied toward securing the permit / any unauthorized changes are made to the site / any unauthorized changes are made in the installation of the system.

☐ *IMPROVEMENT PERMIT w / plat valid without expiration.* ☐ *IMPROVEMENT PERMIT w / site plan valid for 60 mos.* ☐ *AUTHORIZATION TO CONSTRUCT valid for period equal to IMPROVEMENT PERMIT-not to exceed 60 mo.*

Owner / Applicant Signature: Date

Improvement Permit by: Date

Authorzation to Construct by: Date

YOU SHOULD CONTACT A LOCATOR SERVICE PRIOR TO ANY EXCAVATION.

Installed by: Richard Abernathy

Operation Permit by: RS Date: 6/29/12

Existing System Inspected by: Date:

WHITE COPY Environmental Health YELLOW COPY (Final) Owner / Applicant PINK COPY (Initial) Owner / Applicant