IREDELL COUNTY HEALTH DEPARTMENT

STATESVILLE 704-878-5305 MOORESVILLE 704-664-5281

IMPROVEMENT PERMIT / AUTHORIZATION TO CONSTRUCT / OPERATION PERMIT / EXISTING SYSTEM INSPECTION

PERMIT# 12232 PIN# ~~4626556409.457~~ 4626 551501 DATE 6/30/04

OWNER OR CONTRACTOR THE FARMS LLC PHONE: Business 660-1185 Home

ADDRESS 2214 BRAWLEY SCHOOL RD. MOORESVILLE NC 28117

LOCATION BRAWLEY SCHOOL - TR SOUTHFORK - TR ALONG ON RT PAST CHATFIELD

SUBDIVISION THE FARMS BLOCK / SECTION 3 LOT 447 LOT AREA 30,098 ft² SITE CLASS. PS DESIGN FLOW 450GPD L.T.A.R. 30-00/Acre

Septic Tank: 1000 Gallons; STB 794 Date 6/23/08
Pump Tank: Gallons; PT Date
Pump Make: Model Serial No.
Nitrification Field: No. Fields 1 Square Feet 1200 Linear Feet 400
No. Lines 4@100 Trench Width 36" Max Trench Bottom Depth 36" Gravel Depth N/A

☑ New System ☐ Repair System Type: I, II, III, IV, V, VI
System Description: GRAVITY 25% REDUCTION
Repair System Description: LP PANEL
Maintenance Agreement Required: ☐ Yes ☑ No

☑ House/Mod. Home No. Bedrooms 4
☐ Mobile Home No. Bathrooms 4
☐ Business No. Employees
☐ Other
☐ Slab ☑ Crawl Space ☐ Basement w/plumbing ☐ Basement wo/plumbing

Water Supply: ☐ Individual ☐ Public ☑ Community


Comments:/Conditions:

1"=50'


Comments:/Conditions:

System installed as designed
Infiltrator Quick 4 Installed
with end cap stop adapters

INITIAL SITE SKETCH

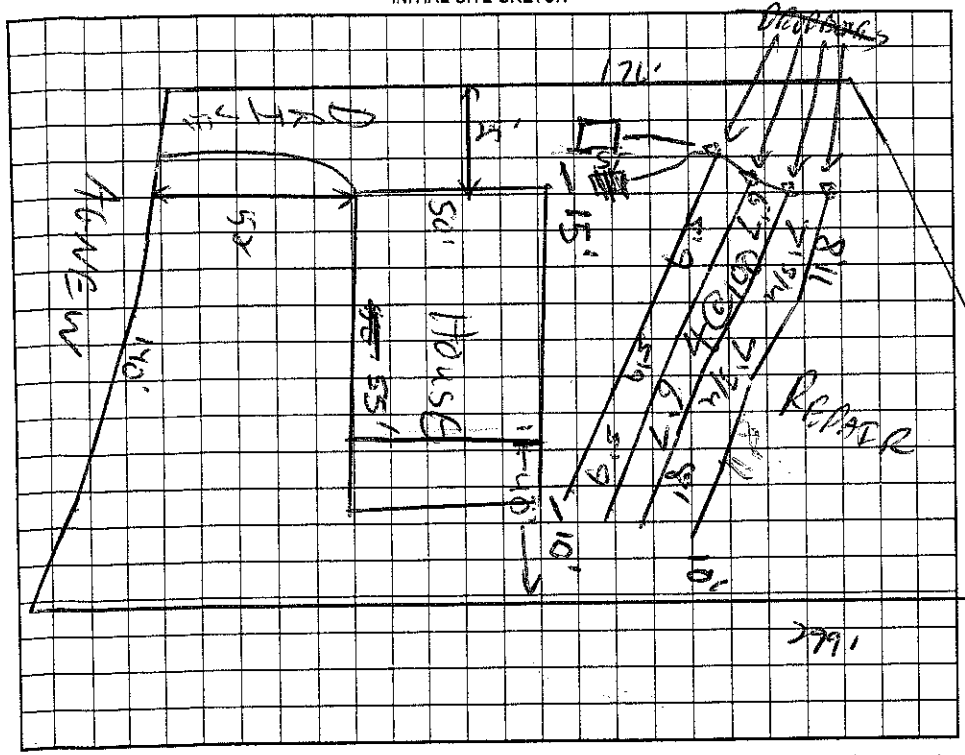

AS BUILT SKETCH

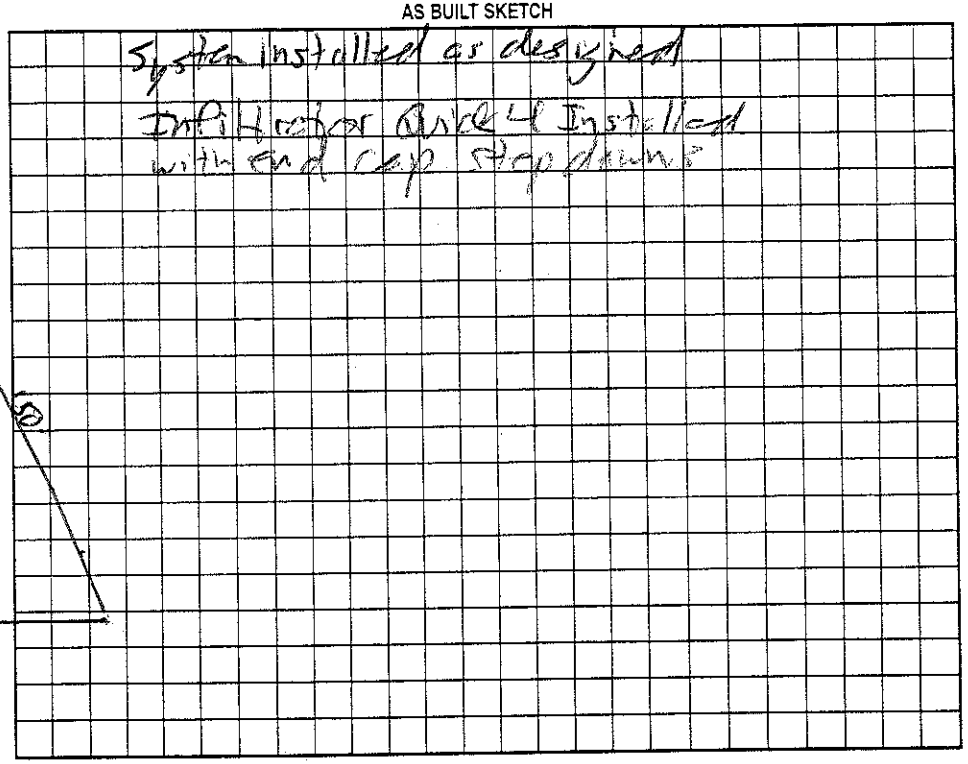

Permit can be suspended or revoked if any false information is supplied toward securing the permit/any unauthorized changes are made to the site/any unauthorized changes are made in the installation of the system. Improvement Permit with plat valid without expiration. Improvement Permit with site plan valid for sixty months. Authorization to Construct is valid for a period equal to that of Improvement Permit – not to exceed sixty months.

Signed: date 1-17-04 Installed by:

Improvement Permit by: date 6/30/04 Operation Permit by: Anthony Coker R.S. date 9/5/08

Authorization to Construct by: date 4-12-07 Existing System Inspection by: date

HEALTH DEPT. COPY: WHITE OWNER COPY (FINAL): YELLOW OWNER COPY (INITIAL): PINK