IREDELL COUNTY HEALTH DEPARTMENT

STATESVILLE 704-878-5305 MOORESVILLE 704-664-5281

IMPROVEMENT PERMIT / AUTHORIZATION TO CONSTRUCT / OPERATION PERMIT / EXISTING SYSTEM INSPECTION

PERMIT # 163761 PIN # 4626-55-2045 DATE 10-27-10

OWNER or APPLICANT JOHN SANCHEZ PHONE: Business 704-201-6474 Home: BRUCE PRINCE

OWNER or APPLICANT ADDRESS 349 AGNEW RD

LOCATION / DIRECTIONS BSR, SOUTHFORK, AGNEW

SUBDIVISION C&T BLOCK / SECTION 8 LOT # 50 LOT AREA _____ DESIGN FLOW 360GPD L.T.A.R. .3

Septic Tank EXISTING Gallons: STB _____ Date _____

Pump Tank _____ Gallons: P T _____ Date _____

Pump Make _____ Model _____ Serial # _____

Nitrification Field No Fields ____ No Lines ~~X~~ Linear Feet _____

Trench Width _____ Max. Trench Bottom Depth _____ Gravel Depth _____

☐ New System ☐ Repair ☐ Expansion System Type I (II) III IV V VI

System Description: GRAVITY GRAVEL BED

Repair System Description: _____

Maintenance Agreement Required ☐ YES ☒ NO

☒ GRAVITY ☐ PRESSURE


☒ Residence No. Bedrooms 3 ☐ Business No. Persons _____ ☐ Other No. Employees _____ ☐ Slab ☒ Crawl Space ☐ Basement w/plumbing ☐ Basement w/o plumbing

Water Supply: ☒ Private ☐ Public ☐ Community


Comments / Conditions: (1) SYSTEM LOOKS GOOD @ INSPECTION

Comments / Conditions

INITIAL SITE SKETCH

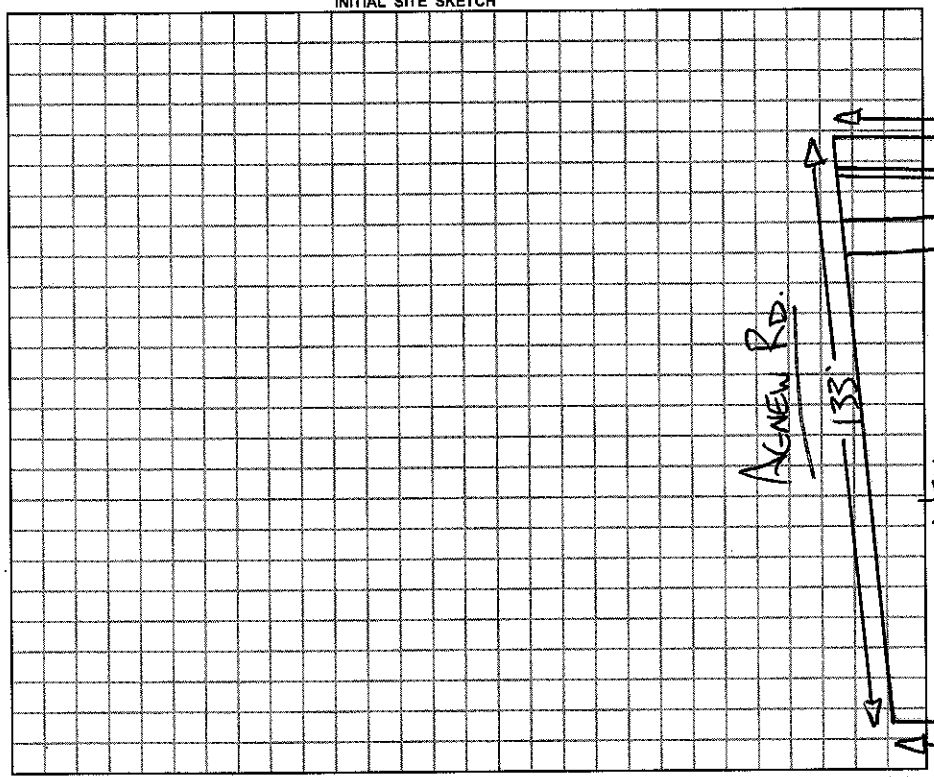

AS BUILT SKETCH

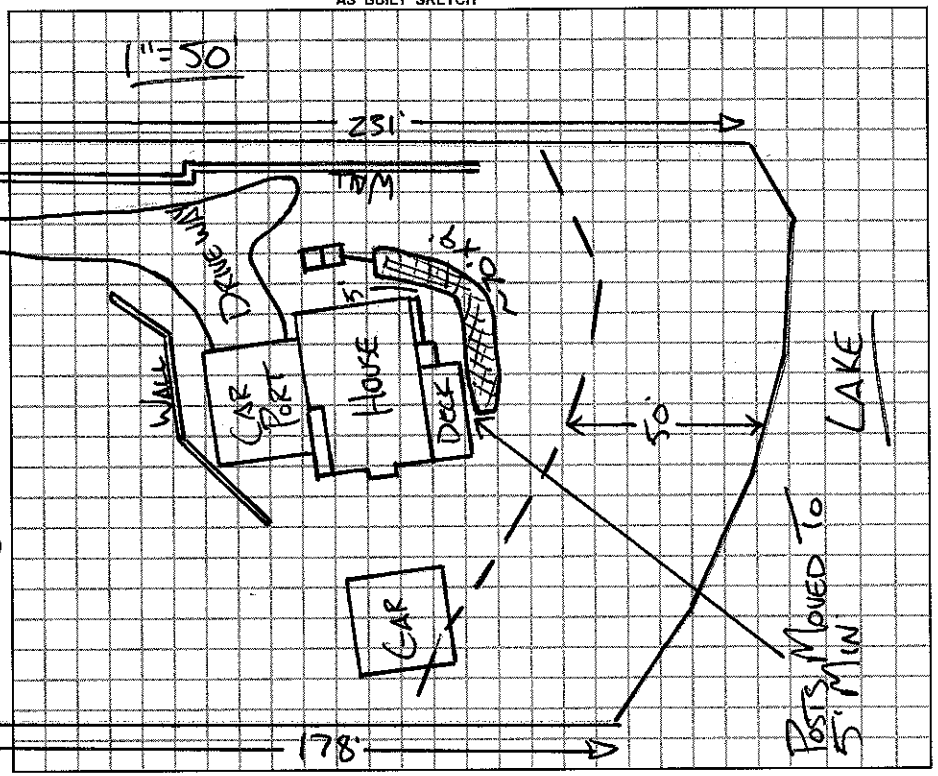

Permit can be suspended or revoked if any false information is supplied toward securing the permit / any unauthorized changes are made to the site / any unauthorized changes are made in the installation of the system.

☐ *IMPROVEMENT PERMIT w / plat valid without expiration.* ☐ *IMPROVEMENT PERMIT w / site plan valid for 60 mos.* ☐ *AUTHORIZATION TO CONSTRUCT valid for period equal to IMPROVEMENT PERMIT-not to exceed 60 mo.*

Owner / Applicant Signature: _____ Date 10/26/10

Improvement Permit by: _____ Date _____

Authorzation to Construct by: _____ Date _____

YOU SHOULD CONTACT A LOCATOR SERVICE PRIOR TO ANY EXCAVATION.

Installed by: _____

Operation Permit by: _____ Date: _____

Existing System Inspected by: _____ REHS Date: 10-27-10

WHITE COPY Environmental Health YELLOW COPY (Final) Owner / Applicant PINK COPY (Initial) Owner / Applicant