DELL COUNTY HEALTH DEPARTMENT

STATESVILLE 704-878-5305 / 130.00 Paid MOORESVILLE 704-664-5281 1:30

OVEMENT PERMIT / AUTHORIZATION TO CONSTRUCT / OPERATION PERMIT / EXISTING SYSTEM INSPECTION

PERMIT# 12872 PIN# 4626e55337 4 DATE 12-14-04

OWNER OR CONTRACTOR Thomas Hanley / ES Johnson Builders PHONE: Business 799-2976 Eric Home (412) 759-1016

ADDRESS 1244 Lamson Circle Pittsburg PA 15241 P.O. Box 1402 Cornelius, NC 28031

LOCATION Brawley School Rd TR Southfork Rd TR Agnew Rd on Rt past Chatfield Cove Dr

SUBDIVISION C & T BLOCK / SECTION 8 LOT 1649 LOT AREA .99 Acre SITE CLASS PS DESIGN FLOW 360gpd L.T.A.R. .3

Septic Tank: 1000 Gallons; STB 799 Date 8-9-05
Pump Tank: 1000 Gallons; PT 27 Date 8-12-05
Pump Make: Zoeller Model 152 Serial No.
Nitrification Field: No Fields 1 Square Feet 600' Linear Feet 300'
No Lines 4 @ 75' Trench Width 36" Max Trench Bottom Depth 36" Gravel Depth N/A

☒ New System ☐ Repair System Type: I, II, (III), IV, V, VI
System Description: Pump-PM-25% Reduction
Repair System Description: Pump-Panel Block
Maintenance Agreement Required: ☐ Yes ☒ No Not Initially

☒ House/Mod. Home No. Bedrooms 3
☐ Mobile Home No. Bathrooms
☐ Business No. Employees
☐ Other
☐ Slab ☐ Crawl Space ☒ Basement w/plumbing ☐ Basement wo/plumbing


Water Supply: ☒ Individual Exist. ☐ Public ☐ Community

Comments:/Conditions: Keep Septic System at least 10' to PL, 50' to lake & 50' to well, Keep ST 15' to House (side slope)

Comments:/Conditions: Note: Pay close attention to Setbacks; drives must not Cross Drainfield. Used Quick 4 Plastic Chambers

INITIAL SITE SKETCH

Scale 1:60

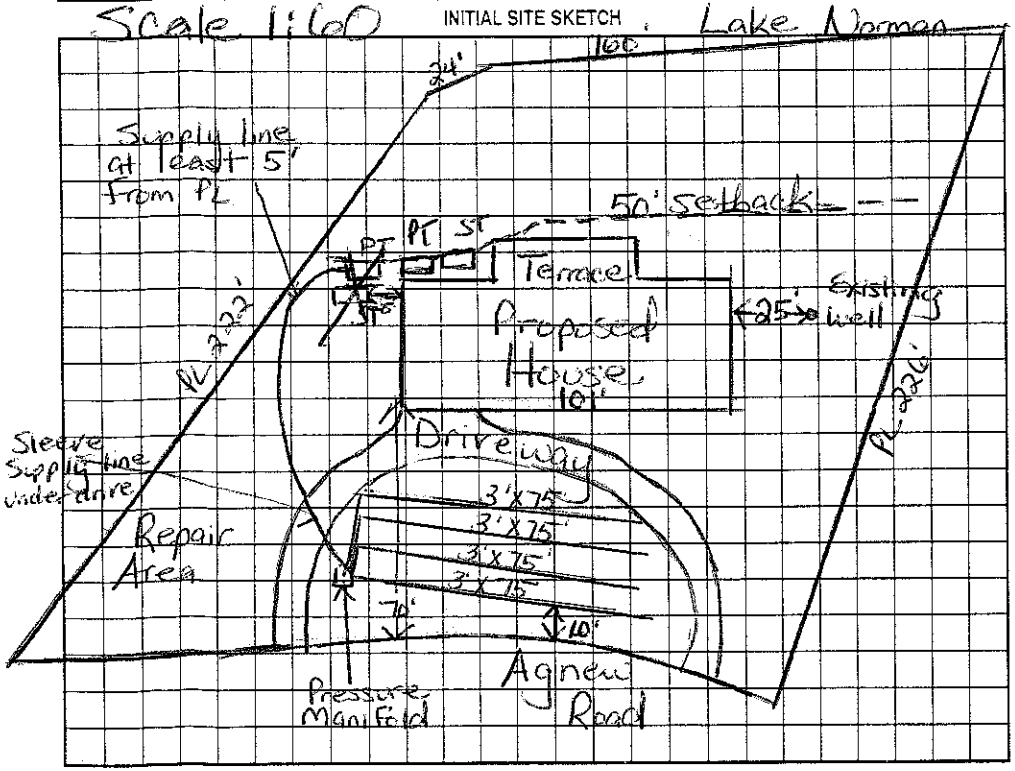

AS BUILT SKETCH 12/7/05 Tanks, press & lines checked

Installed as Drawn
Set 3ft of Head
Checked Lines, tanks & pressure.

Permit can be suspended or revoked if any false information is supplied toward securing the permit/any unauthorized changes are made to the site/any unauthorized changes are made in the installation of the system. Improvement Permit with plat valid without expiration. Improvement Permit with site plan valid for sixty months. Authorization to Construct is valid for a period equal to that of Improvement Permit -- not to exceed sixty months.

Signed: Margie DiBella date 12/30/04

Improvement Permit by: Maina H. Dotson RS date 12/14/04

Authorization to Construct by: Maina H. Dotson RS date 12/14/04

Installed by: Willie Christenbury

Operation Permit by: Maina H. Dotson RS date 1/1/05

Existing System Inspection by: date

HEALTH DEPT. COPY: WHITE OWNER COPY (FINAL): YELLOW OWNER COPY (INITIAL): PINK