IREDELL COUNTY HEALTH DEPARTMENT

Statesville Phone TR 3-7271 Mooresville Phone NO 3-1271

PERMIT TO INSTALL SEPTIC TANK

Permit No. 105 Permit Date 6-15- 1972

Owner Jim Davis Address Charlotte

Installed By Avery Address Catawba Co.


Location of Property Sec 8 Lot 44

Tank		Capacity		Length of Lines		Fixtures	
Block	( )	1000	(✓)	225'	( )	No. of Baths	(1)
Precast	(✓)	1250	( )	250'	( )	Dishwasher	(not
		1500	( )	Other 60		Garbage Grdr.	(no
		Other				Other	

NOTIFY HEALTH DEPARTMENT AT LEAST EIGHT HOURS BEFORE TANK IS TO BE INSPECTED.

Final Inspection 6-15- 1972 Approved ( ) Disapproved ( )

Remarks 5 feet of gravel put in 5'X30' ditch This was installed because of the location of his Trailor and well on the lot.

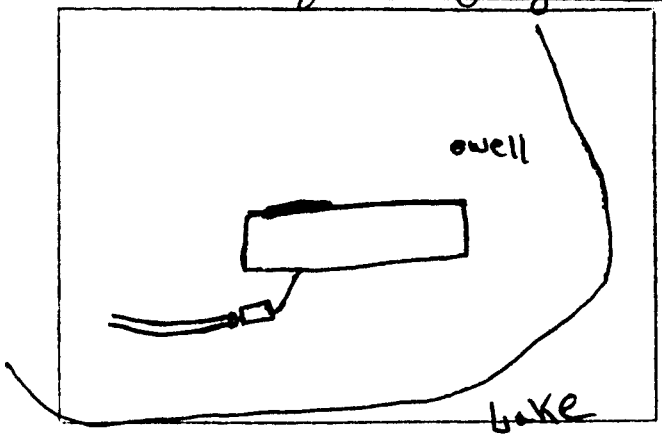

Sketch of Installation

D. C. Moore

Sanitarian