Lot 1651 4626556613 P125

IREDELL COUNTY HEALTH DEPARTMENT

STATESVILLE 704-878-5305 MOORESVILLE 704-664-5281

IMPROVEMENT PERMIT / CERTIFICATE OF COMPLETION / OPERATION PERMIT / EXISTING SYSTEM INSPECTION

PROPERTY DESCRIPTION NO. 066415 DATE 4/28/97 TAX MAP NO. 4626556632 Watershed: ☑ Yes ☐ No

OWNER OR CONTRACTOR CRESCENT RESOURCES (GARY BURKE) PHONE: Business 663-6905 - T. JACOBS Home

ADDRESS PO BOX 1003 CHARLOTTE NC 28201

LOCATION BRAWLEY SCHOOL RD - TR SOUTHFORK - GO RT AGNEW RD - ½ MILE ON LEFT

SUBDIVISION CL+T BLOCK / SECTION 8 LOT ~~65~~ 65 LOT AREA ~1.22 AC SITE CLASS. RS DESIGN FLOW 480 GPD L.T.A.R. .36 GPD/FT²

Septic Tank: 1000 Gallons; STB 794 Date 3/17/98

Pump Tank: 1000 Gallons; PT 27 Date 4/4/98

Pump Make: HYDROMATIC Model SNEF100A2 Serial No. 8/97

Nitrification Field: No Fields 1 Square Feet 1200 Linear Feet 400

No Lines 4@100' Trench Width 36" Max Trench Bottom Depth 36 Gravel Depth N/A

☑ New System ☐ Repair System Type: I, II, (III), IV, V, VI

System Description: PUMP CHAMBERED OR SIMILAR TYPE

Repair System Description: SAME

Maintenance Agreement Required: ☐ Yes ☑ No

☑ House/Mod. Home No. Bedrooms 4

☐ Mobile Home No. Bathrooms 4

☐ Business No. Employees

☐ Other

☐ Slab ☐ Crawl Space ☑ Basement w/plumbing ☐ Basement wo/plumbing


Water Supply: ☑ Individual ☐ Community ☐ Public

Comments: (LOT 1651)


Comments: IMPROVEMENT PERMIT ONLY - DO NOT ISSUE BUILDING PERMIT.

TANKS CHANGED

INITIAL SITE SKETCH 1"=100'

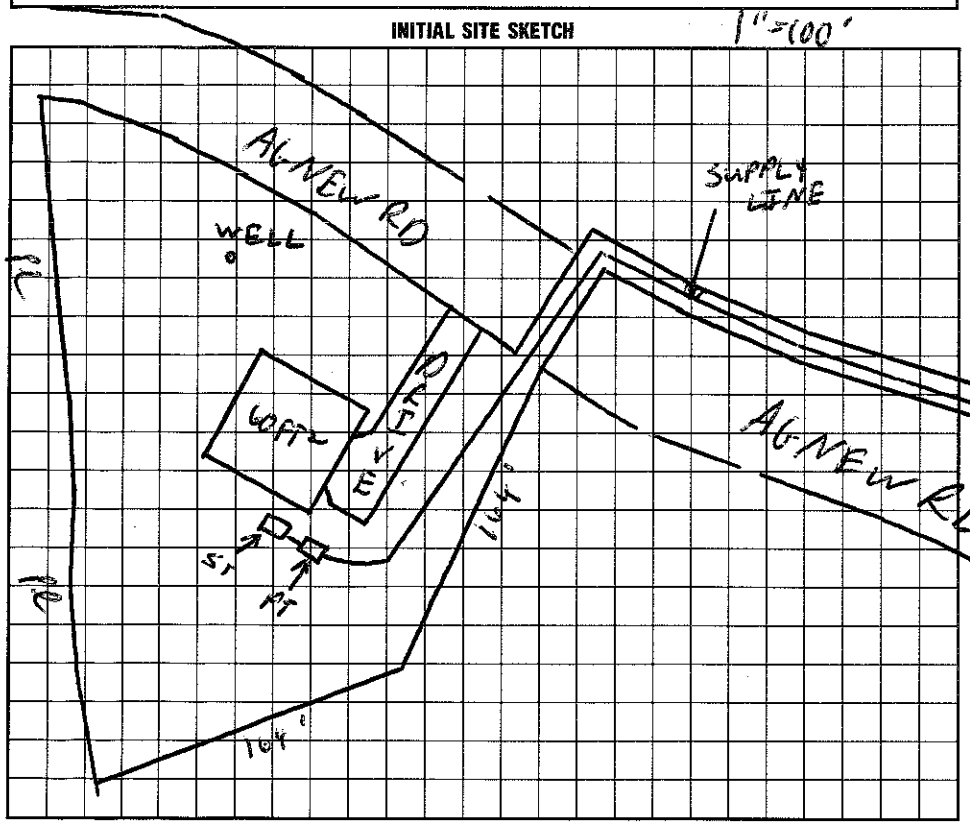

AS BUILT SKETCH

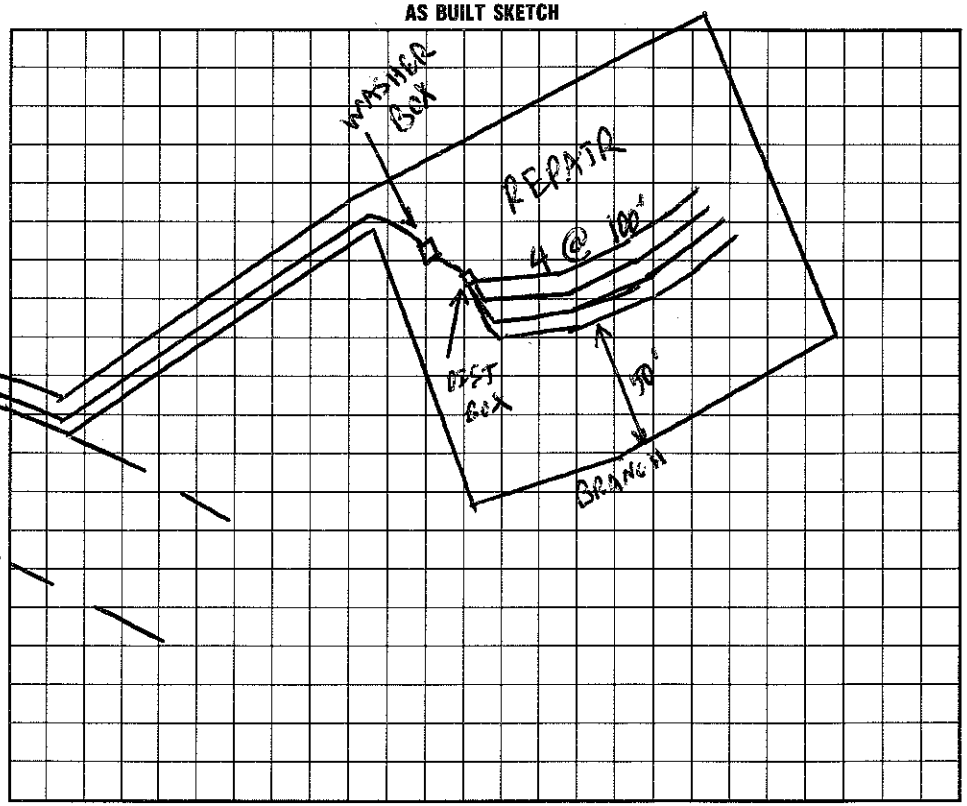

I understand that this permit can be suspended or revoked if any false information is supplied toward securing the permit/any unauthorized changes are made to the site/any unauthorized changes are made in the installation of the system. Improvement Permit is valid for 60 months from date of issuance.

Signed: Agent

Improvement Permit by: EHS date 4/28/97

Existing System Inspection by: RS date 3/20/98

Installed by: Tim Simmons

Certificate of Completion by: Wesley Sparks RS. date 11/12/98

Operation Permit by: date

HEALTH DEPT. COPY: WHITE INSPECTION COPY (FINAL): GREEN OWNER COPY (FINAL): YELLOW INSPECTION COPY (INITIAL): PINK OWNER COPY (INITIAL): GOLD