III B (1400) #150

IREDELL COUNTY HEALTH DEPARTMENT

AUTHORIZATION TO CONSTRUCT

STATESVILLE 704-878-5305 MOORESVILLE 704-664-5281

IMPROVEMENT PERMIT / ~~CERTIFICATE OF COMPLETION~~ / OPERATION PERMIT / EXISTING SYSTEM INSPECTION

PROPERTY DESCRIPTION NO. 25293 DATE 4/25/97 TAX MAP NO. 2F-2-A-40C pt of 4626558553 Watershed: ☑ Yes ☐

OWNER OR CONTRACTOR PHIL YORK PHONE: Business Home 664-6375

ADDRESS 163 WOODSTREAM DR MOORESVILLE NC 28115

LOCATION BRAWLEY SCHOOL RD - TR SOUTH FORK - 60 CT - AGNEW - ON LEFT 285 Agnew NOW LOTS 142

SUBDIVISION CL OF BLOCK / SECTION 8 LOT ~~1652~~ ~~COMBINED~~ 2 Lots 142 SITE CLASS. RS DESIGN FLOW 450 GPD L.T.A.R. .36 GPD/FT²

Septic Tank: 1000 Gallons; STB 794 Date 11/6/97

Pump Tank: 1000 Gallons; PT 97 Date 2/9/98

Pump Make: Model Serial No.

Nitrification Field: No Fields 1 Square Feet 1240 Linear Feet 400

No Lines 4@100' Trench Width 36" Max Trench Bottom Depth 36" Gravel Depth N/A

☑ New System ☐ Repair System Type: I, II, (III), IV, V, VI

System Description: PUMP CHAMBERED OR SIMILAR

Repair System Description: PUMP PANEL

Maintenance Agreement Required: ☐ Yes ☑ No

☑ ~~House~~/Mod. Home ☐ Mobile Home ☐ Business ☐ Other

No. Bedrooms 4 No. Bathrooms 4 No. Employees


Water Supply: ☑ Individual ☐ Community ☐ Public

☐ Slab ☐ Crawl Space ☑ Basement w/plumbing ☐ Basement wo/plumbing

Comments:

Comments:

INITIAL SITE SKETCH 1" = 100'

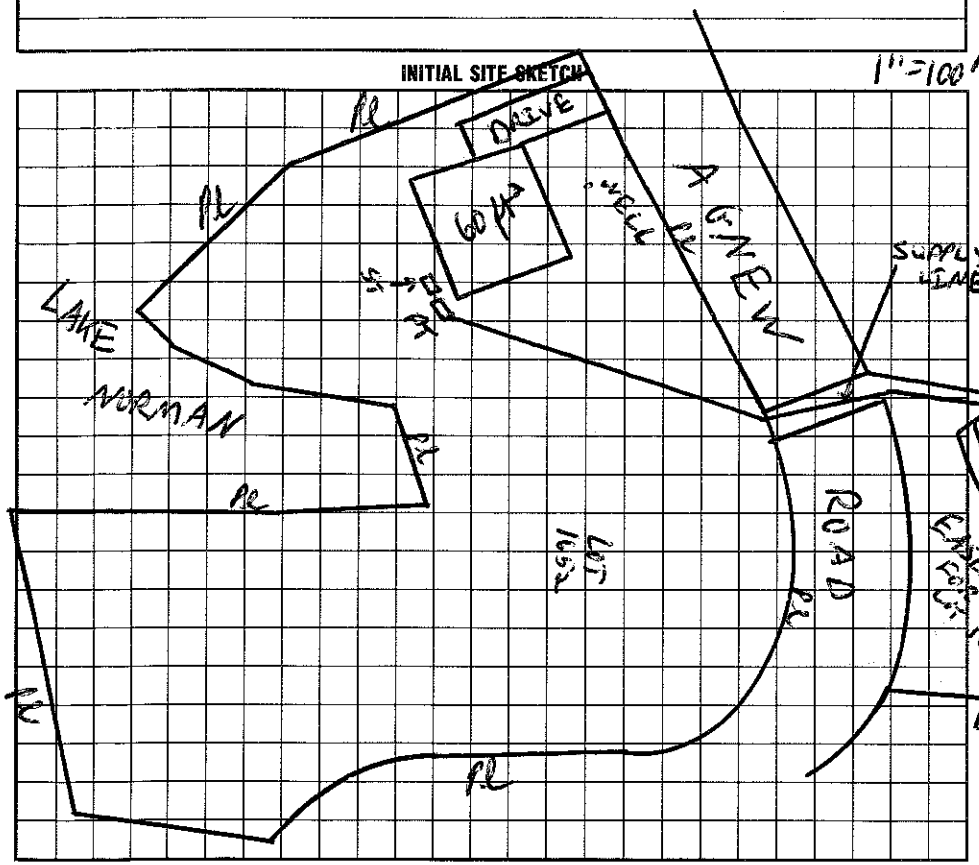

AS BUILT SKETCH

I understand that this permit can be suspended or revoked if any false information is supplied toward securing the permit/any unauthorized changes are made to the site/any unauthorized changes are made in the installation of the system. Improvement ~~Permit is~~ valid for ~~60~~ months from date of issuance.

Signed: Jerry Griggs Agent

Installed by: TIM AMMONS

Improvement Permit by: C. Ray Lee date 4/25/97

Certificate of Completion by: date

~~Existing System Inspection by:~~ AUTHORIZATION TO CONSTRUCT C. Ray Lee date 4/25/97

Operation Permit by: C. Ray Lee date 4/16/98

HEALTH DEPT. COPY: WHITE INSPECTION COPY (FINAL): GREEN OWNER COPY (FINAL): YELLOW INSPECTION COPY (INITIAL): PINK OWNER COPY (INITIAL): GOLD